

MISSISSIPPI DEPARTMENT OF ENVIRONMENTAL QUALITY

Office of Land and Water Resources

P. O. Box 10631  
Jackson, MS 39289-0631  
WATER WELL DRILLERS LOG

COUNTY WELL LOCATED  
*Marshall*

WELL NUMBER CODED  
*R 2063*

DATE WELL COMPLETED  
*5-22-97*

HICK WATER WELL CO.  
30242 HWY. 4 EAST  
SENATOBIA, MS 38668

NAME & MAILING ADDRESS OF LANDOWNER  
*Claude Green*  
*1727 Tyro Rd*  
*Holly Springs, MS 38635*

WELL LOCATION: SEC TOWNSHIP RANGE  
*30 5 N 4 E*

DISTANCE DIRECTION NEAREST TOWN  
*2* Miles *SE* of *WYATTE*

OTHER LANDMARK

WELL PURPOSE: *Home Irrigation*, Municipal, Industrial, Fish Pond, etc.

PUMP DATA

PUMP TYPE (Circle One):  
 Submersible Turbine Jet Flowing Well,  
Other (Describe)

POWER TYPE (Circle One):  
 Electric Tractor Diesel Gasoline *3/4* Butane  
Other (Describe) H/P

Pump Capacity (GPM) No. of Stages Setting Depth  
*12* *180* FT.

PUMP TEST

Well yielded *NO* GPM with  
a drawdown of *TEST* ft.  
after \_\_\_\_\_ hours of pumping

WELL DATA

Well Depth <i>240</i>	Casing Diameter (In.) <i>4</i>	Casing Length (Ft.) <i>230</i>
Type of Casing <i>PVC</i>	Hole Depth <i>240</i>	Depth to Static Water Level <i>160</i>

TYPE OF COMPLETION: (Circle One or More):  
 Gravel Packed Underreamed Telescoped,  
Natural Development, Open Hole, Other  
(Describe)

WELL GROUTED TO A DEPTH OF *3* FEET  
Type Grout (circle one):  Cement Bentonite, or Mix

LOG DATA

TYPE OF LOG RUN (Circle One):  
 No Log Run  
Electric, Gamma Ray, Density, Sonic, Neutron,  
Other (Describe)

Name of Organization Running Log

SCREEN DATA

Diameter - Inches <i>4</i>	Length - Feet <i>10</i>	Slot Size - Inches <i>.013</i>
Screen Type <i>PVC slot</i>	Depth to Bottom - Feet <i>230</i>	

GEOLOGIC DATA (Office Use Only)

Surface Elev.	Geologic Unit	Unit Thickness	Depth to Top
Subs. SWL	Date	Analysis	Aquifer Test

Driller's Remarks

Top of Lap Pipe or Reduction in Casing

FEET IF TELESCOPED OR MORE THAN ONE SCREEN: USE BACK PAGE

DESCRIPTION OF FORMATIONS ENCOUNTERED	FROM	TO
<i>Red Clay</i>	<i>0</i>	<i>10</i>
<i>Red Sand</i>	<i>10</i>	<i>40</i>
<i>White Sand &amp; Clay</i>	<i>40</i>	<i>100</i>
<i>White Sand</i>	<i>100</i>	<i>240</i>

FORM AND LOG CONTINUED FROM TO

**RECEIVED**


*JUL 01 1997*

Dept. of Environmental Quality  
Office of Land & Water Resources

IF MORE SPACE IS NEEDED, USE BACK

If well telescopes please  
sketch and show depths.

GROUND LEVEL

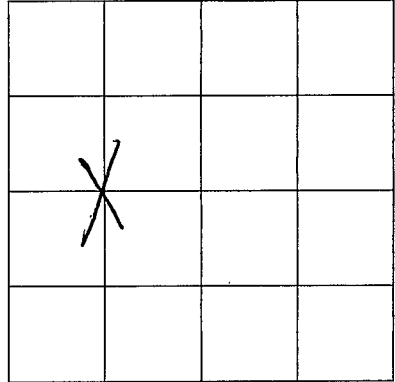

SECTION 30

Please indicate well location X.

ADDITIONAL INFORMATION

If more than one screen,  
show location of each on sketch.