

MISSISSIPPI DEPARTMENT OF ENVIRONMENTAL QUALITY
Office of Land and Water Resources

P. O. Box 10631
Jackson, MS 39289-0631
WATER WELL DRILLERS LOG

COUNTY WELL LOCATED MARSHALL	
WELL NUMBER R 2065	CODED
DATE WELL COMPLETED 11-16-99	

PERMIT NUMBER
NAME OF DRILLING FIRM HICKS WELL CO.

NAME & MAILING ADDRESS OF LANDOWNER NEW JAMISON Chapel CME			
Yo Lillie B. HAYES			
3423 Poagville Rd			
Coldwater, MS 38618			
WELL LOCATION	SEC	TOWNSHIP	RANGE
	17	5 N	4 E
DISTANCE	DIRECTION	NEAREST TOWN	
1 Miles	W	of Chulahoma	
OTHER LANDMARK Hwy 4 Just E of Hwy 309			
WELL PURPOSE Home, Irrigation, Municipal, Industrial, Fish Pond, etc. Church			

PUMP DATA		
PUMP TYPE (Circle One): Submersible Turbine, Jet, Flowing Well, Other (Describe)		
POWER TYPE (Circle One): Electric Tractor, Diesel, Gasoline 3/4 Butane, Other (Describe) H/P		
Pump Capacity (GPM) 12	No of Stages	Setting Depth 140 FT.
PUMP TEST		
Well yielded 500 GPM with a drawdown of Test ft. after _____ hours of pumping		

WELL DATA		
Well Depth 220	Casing Diameter (In) 4	Casing Length (Ft) 210
Type of Casing: PVC	Hole Depth 220	Depth to Static Water Level 110
TYPE OF COMPLETION: (Circle One or More): Gravel Packed Underreamed, Telescoped, Natural Development, Open Hole, Other (Describe)		

LOG DATA			
TYPE OF LOG RUN (Circle One): Electric, Gamma Ray, Density, Sonic, No Log Run , Other (Describe) Neutron			
Name of Organization Running Log			

WELL GROUTED TO A DEPTH OF 3 FEET
Type Grout (circle one): Cement Bentonite or Mix

GEOLOGIC DATA (Office Use Only)			
Surface Elev	Geologic Unit	Unit Thickness	Depth to Top
Subs. SWL	Date	Analysis	Aquifer Test

SCREEN DATA		
Diameter - Inches 4	Length - Feet 10	Slot Size - Inches .014
Screen Type PVC Slot	Depth to Bottom - Feet 210	


Driller's Remarks	
Top of Lap Pipe or Reduction in Casing	
FEET	IF TELESCOPED OR MORE THAN ONE SCREEN: USE BACK PAGE

DESCRIPTION OF FORMATIONS ENCOUNTERED	FROM	TO
Brown + White Clay	0	10
Red Sand + Clay	10	15
White Clay	15	35
White Sand + Clay	35	160
White Sand	160	220

FORMATIONS (Continued)		FROM	TO
INDICATED			
JAN 04 2000			
Dept of Environmental Quality Office of Land & Water Resources			
IF MORE SPACE IS NEEDED, USE BACK			

If well telescopes please sketch and show depths.

GROUND LEVEL

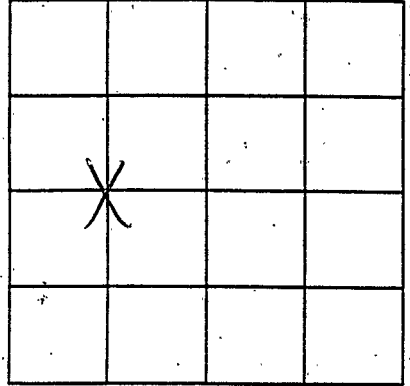

SECTION 17

Please indicate well location X.

ADDITIONAL INFORMATION

RECEIVED

JUN 4 1968

U.S. GEOLOGICAL SURVEY
WATER RESOURCES DIVISION

If more than one screen,
show location of each on sketch.