

15F

CODED

Marshall
SI
6-27-68

MISSISSIPPI
BOARD OF WATER COMMISSIONERS
416 North State Street
Jackson, Mississippi 39201

WATER WELL DRILLERS LOG

CODED

June 27 1968 R. L. Carpenter Marshall
date well completed firm name county well located

LANDOWNER: J. J. Wisient

description of formations encountered

from to

Waterford, Miss.

Surface Soil 0 16

R.F.D.
(mailing address)

Med Red Sand 16 31

WELL LOCATION:

sec. 25 T. 5 N. R. 3 E.
(S) (W)

Med Red + White Sand 31 65

Three miles South of Waterford
(distance) (direction) (nearest town)

Blue Mud 65 135

WELL PURPOSE: Home Use
(home, irrigation, municipal, industrial)

Med. + Fine White Sand 135 165

WELL COMPLETION DATA:

(1) diameter (inches) 4 in.

(2) total depth (feet) 16.5 Feet

(3) static water level (feet) 20 below top of ground.

(4) casing Plastic, 159 ft.
(material) (depth)

(size) if telescope see back.

(5) screen 6 ft., 159 ft.
(length) (depth to top)

4 in., Plastic + Gravel
(size) (material)

(6) pump 3/4 7
(HP) (yield gpm)

Edison
(type power)

(7) electric log No.
(yes or no)

(organization running log)

(8) how well bottom plugged Plastic plug

CODED

JAN 29 1969

MISS. RD. OF
WATER COM.


DRILLERS REMARKS:

If well telescopes please sketch and show depths.

GROUND LEVEL

R3W

TSS

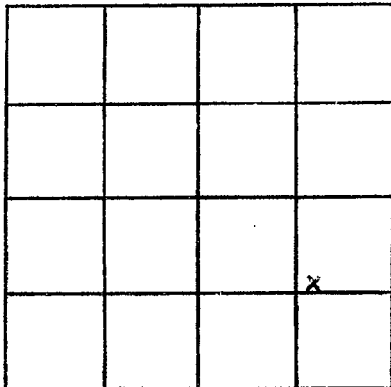

SECTION 25

Please indicate well location X.

ADDITIONAL INFORMATION

If more than one screen, show locations of each on sketch.