

MARSHALL
 S 2
 10-14-68

MISSISSIPPI BOARD OF WATER COMMISSIONERS
 416 North State Street
 Jackson, Mississippi 39201

WATER WELL DRILLERS LOG

Oct 14 1968 Bumpus Well Co Marshall
 date well completed firm name county well located

LANDOWNER:	description of formations encountered	from	
<u>Edward Jeffers</u> <u>Rt 5 Halls Springs Miss</u> (mailing address)	<u>Red Clay</u> <u>30 ft</u>	<u>0-30</u> <u>30 ft</u>	
WELL LOCATION:			
sec <u>9</u> T <u>5</u> N R <u>3</u> E S W <u>2 miles</u> miles <u>West</u> of <u>Waterford</u> (distance) (direction) (nearest town)			
WELL PURPOSE: (home, irrigation, municipal, industrial)			
WELL COMPLETION DATA:			
(1) diameter (inches) <u>4"</u>	RODEN		
(2) total depth (feet) <u>240</u>			
(3) static water level (feet) <u>190</u> <u>below</u> top of ground.			
(4) casing <u>4" gal</u> , <u>183</u> (material) (depth)			
_____ if telescope see back.			
(5) screen <u>24"</u> , <u>183</u> (length) (depth to top)			
(6) pump <u>3/4</u> , <u>10 gal</u> (HP) (yield gpm)			
<u>Elect</u> (type power)			
(7) electric log (yes or no) _____			
_____ (organization running log)			
(8) how well bottom plugged <u>4" cap</u>			


FEB 17 1969

MISS. DR. CO.
 WATER DIVISION

DRILLERS REMARKS:

If well telescopes please
sketch and show depths.

GROUND LEVEL

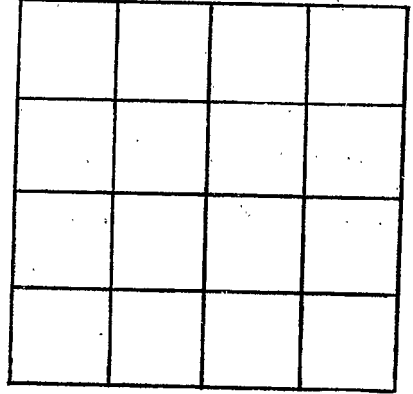

SECTION _____

Please indicate well location X.

ADDITIONAL INFORMATION

If more than one screen,
show locations of each on sketch.