

MARSHALL

53

10-18-68

MISSISSIPPI
 BOARD OF WATER COMMISSIONERS
 416 North State Street
 Jackson, Mississippi 39201

CODED

CODED

WATER WELL DRILLERS LOG

Oct. 18 1968

Bumpas Well Co

Marshall

date well completed

firm name

county well located

LANDOWNER:

Robert Lee Curry
 P#5 Holly Springs Miss
 (mailing address)

description of formations encountered

from

to

Clay

0 30
30 250

WELL LOCATION:

sec. 10 T 5 N R 3 E
 S W
 2 1/4 miles west of Watfard
 (distance) (direction) (nearest town)

WELL PURPOSE:

(home, irrigation, municipal, industrial)

WELL COMPLETION DATA:

- (1) diameter (inches) 4"
- (2) total depth (feet) 250
- (3) static water level (feet) 145 below top of ground.

(4) casing 4" A.C. 243
 (material) (depth)

(size) If telescope see back.

(5) screen 7" 243
 (length) (depth to top)

4" Out. Sand gravel
 (size) (material)

(6) pump 3/4 10 gal
 (HP) (yield/gpm)

Elect
 (type power)

(7) electric log (yes or no)

(organization running log)

(8) how well bottom plugged 4" Cap


DRILLERS REMARKS:

FORM 4 - 10/60

MISS. BD. OF WATER COM.

If well telescopes please sketch and show depths.

GROUND LEVEL

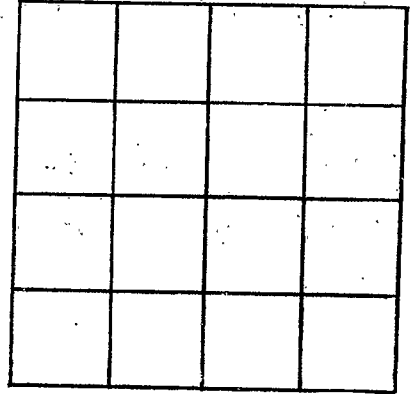

SECTION _____

Please indicate well location X.

ADDITIONAL INFORMATION

If more than one screen,
show locations of each on sketch.