

ltn 9/11/69 for  
and. Imps.

CODED

MISSISSIPPI  
BOARD OF WATER COMMISSIONERS  
416 North State Street  
Jackson, Mississippi 39201

WATER WELL DRILLERS LOG

Atkinson & Frost

Marshall

19 date well completed

firm name

county well located

LANDOWNER:

McKineley Wolfe

description of formations encountered

from

to

Holly Springs miss  
(mailing address)

CLAY  
Red Sand  
White Sand

0 20  
20 80  
80 160

WELL LOCATION:

sec. 3 T. 5 N. R. 3 E  
6 miles (distance) E of (direction) of (nearest town) Chulahoma

WELL PURPOSE: home  
(home, irrigation, municipal, industrial)

WELL COMPLETION DATA:

- (1) diameter (inches) 4"
- (2) total depth (feet) 160
- (3) static water level (feet) 120 below top of ground.
- (4) casing PVC, 160 (material) (depth)  
(size) if telescope see back.
- (5) screen 10 150 (length) (depth to top)  
1 1/2" PVC (size) (material)
- (6) pump 3/4 10 (HP) (yield gpm)  
Elec (type power)
- (7) electric log (yes or no)
- (organization running log)
- (8) how well bottom plugged cap


DRILLERS REMARKS:

MISS. BD. OF  
WATER COMMISSIONERS

5 15 30

If well telescopes please sketch and show depths.

GROUND LEVEL

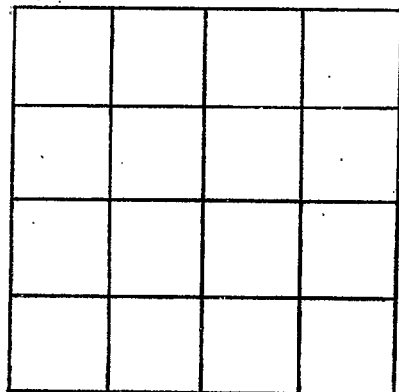

SECTION \_\_\_\_\_

Please indicate well location X.

ADDITIONAL INFORMATION

If more than one screen, show locations of each on sketch.