

Marshall
57
10-28-69

MISSISSIPPI
BOARD OF WATER COMMISSIONERS
416 North State Street
Jackson, Mississippi 39201

CODED

WATER WELL DRILLERS LOG


10-28 1969 Demposwell Co Marshall
date well completed firm name county well located

LANDOWNER	description of formations encountered	from	to
James Harrison	Clay	0	20
Waterford, Miss. (mailing address)	Sand	20	50
WELL LOCATION: sec. 24 T. 5 N R. 3 E 1 S W 1 miles South of Waterford (distance) (direction) (nearest town)	Clay	50	70
WELL PURPOSE: (home, irrigation, municipal, industrial)	Sand	70	190
WELL COMPLETION DATA: (1) diameter (inches) 4" (2) total depth (feet) 190 feet (3) static water level (feet) 30 below above top of ground. (4) casing PVC, 190 feet (material) (depth) (size) if telescope see back. (5) screen 6 ft, 184 feet (length) (depth to top) 4" gravel wash (size) (material) (6) pump 3/4 HP, 10 (yield gpm) (type power) (7) electric log Elect. (yes or no) (organization running log) (8) how well bottom plugged 4" cap			
DRILLERS REMARKS:			

DEC 1 1969
MISS. Bd. of WATER COMMISSIONERS

If well telescopes please sketch and show depths.

GROUND LEVEL

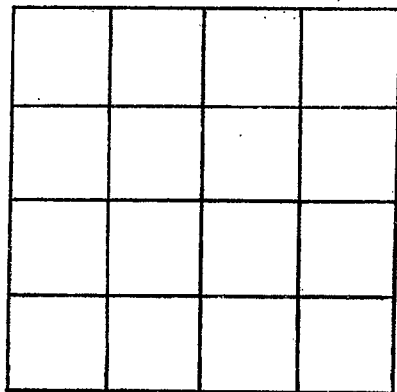

SECTION _____

Please indicate well location X.

ADDITIONAL INFORMATION

If more than one screen,
show locations of each on sketch.