

Marshall
S 8

MISSISSIPPI
 BOARD OF WATER COMMISSIONERS
 416 North State Street
 Jackson, Mississippi 39201

CODED

WATER WELL DRILLERS LOG

Atkinson & Frost Marshall

date well completed

firm name

county well located

LANDOWNER:	description of formations encountered	from	to
<p><u>RAY Gallagher</u> <u>Waterford Miss</u> (mailing address)</p>	<p><u>clay</u> <u>white SAND</u></p>	<p><u>0</u></p>	<p><u>10</u> <u>85</u></p>
WELL LOCATION:			
<p>sec. <u>5</u> T. <u>5</u> N. R. <u>3</u> E <u>0</u> miles <u>IN</u> of <u>Waterford</u> (distance) (direction) (nearest town)</p>			
WELL PURPOSE: (home, irrigation, municipal, industrial)			
WELL COMPLETION DATA:			
(1) diameter (inches) <u>4</u>			
(2) total depth (feet) _____			
(3) static water level (feet) <u>50</u> below/above top of ground.			
(4) casing <u>P.V.C.</u> <u>85</u> (material) (depth)			
(size) if telescope see back.			
(5) screen <u>10.5'</u> <u>80</u> (length) (depth to top)			
<u>4</u> <u>P.V.C.</u> (size) (material)			
(6) pump <u>1/4</u> <u>15</u> (HP) (yield gpm)			
<u>Elec.</u> (type power)			
(7) electric log _____ (yes or no)			
(organization running log)			
(8) how well bottom plugged <u>CRP.</u>			
DRILLERS REMARKS:			


CODED

APR 17 1970

MISS. BR. OF
 WATER COMM.

If well telescopes please sketch and show depths.

GROUND LEVEL

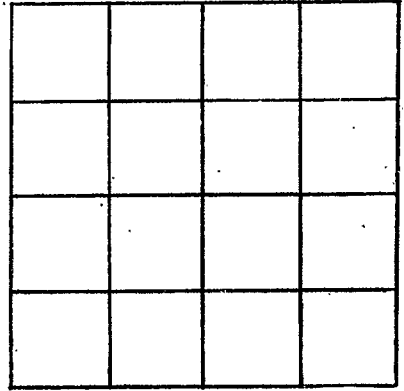

SECTION _____

Please indicate well location X.

ADDITIONAL INFORMATION

If more than one screen, show locations of each on sketch.