

Marshall  
S 9  
2-26-70

MISSISSIPPI  
BOARD OF WATER COMMISSIONERS  
416 North State Street  
Jackson, Mississippi 39201

CODED

WATER WELL DRILLERS LOG

2-26-70 date well completed 70 Bumpas Wells Co. firm name Marshall county well located

LANDOWNER:  
Ellie Foster  
Waterford Miss.  
(mailing address)

WELL LOCATION:  
sec 16 T 5 N R 5 E  
4 miles S-W of Waterford  
(distance) (direction) (nearest town)

| description of formations encountered | from | to  |
|---------------------------------------|------|-----|
| clay                                  | 0    | 10  |
| Gravel                                | 10   | 180 |

WELL PURPOSE: Dwellers  
(home, irrigation, municipal, industrial)

WELL COMPLETION DATA:

(1) diameter (inches) 4"

(2) total depth (feet) 180 feet

(3) static water level (feet) 160 below above top of ground.

(4) casing PVC, 180 feet (material) (depth)

(size) if telescope see back.

(5) screen 6ft., 174 feet (length) (depth to top)

4" gravel well (size) (material)

(6) pump 3/4 (HP) 10 (yield gpm)

(type power)

(7) electric log elect. (yes or no)

(organization running log)

(8) how well bottom plugged 4" Cop.


DRILLERS REMARKS:

MAY 25 1970

MISS. BD. OF  
WATER COMM.

If well telescopes please sketch and show depths.

GROUND LEVEL

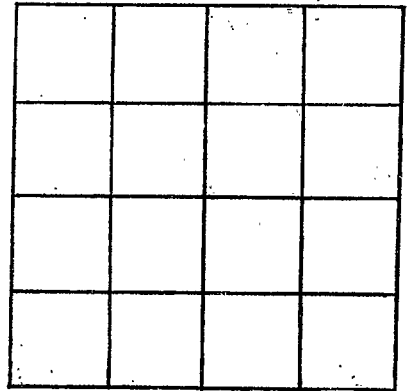

SECTION \_\_\_\_\_

Please indicate well location X.

ADDITIONAL INFORMATION

If more than one screen, show locations of each on sketch.