

MARSHALL

510

10-20-70

MISSISSIPPI BOARD OF WATER COMMISSIONERS
416 North State Street
Jackson, Mississippi 39201

CODED

WATER WELL DRILLERS LOG

Marshall

10-20-1970 Bumpas Well Co.

date well completed

Dean & Karl Bumpas

firm name

county well located

LANDOWNER:

James Melore

RTS, Holly Springs, Miss.
(mailing address)

description of formations encountered

clay

from

to

0 20

Sand

20 220

WELL LOCATION:

sec. 10 T 5 N R 3 E
5 miles WEST of WATERFORD
(distance) (direction) (nearest town)

WELL PURPOSE: Dwelling
(home, irrigation, municipal, industrial)

WELL COMPLETION DATA:

- (1) diameter (inches) 4"
- (2) total depth (feet) 220 feet
- (3) static water level (feet) 150 ^{below} _{above} top of ground.
- (4) casing PVC 220ft
(material) (depth)
- (size) If telescope see back.
- (5) screen 6ft 214ft
(length) (depth to top)
- 4" gravel wall
(size) (material)
- (6) pump 3/4 10
(HP) (yield gpm)
- (type power)

(7) electric log elect.
(yes or no)

(organization running log)

(8) how well bottom plugged 4" cap.

CODED

NOV 13 1970


MISS. BD. OF WATER COMM.

DRILLERS REMARKS:

~~_____~~

If well telescopes please sketch and show depths.

GROUND LEVEL

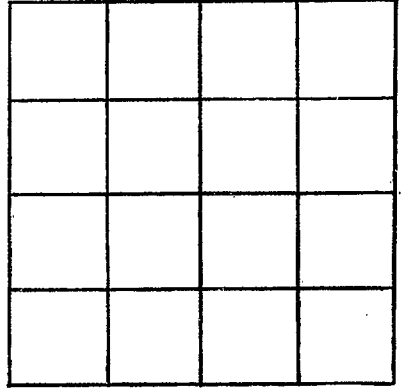

SECTION _____

Please indicate well location X.

ADDITIONAL INFORMATION

If more than one screen, show locations of each on sketch.