

MARSHALL
SIL
3-9-71

MISSISSIPPI
BOARD OF WATER COMMISSIONERS
416 North State Street
Jackson, Mississippi 39201

CODED

WATER WELL DRILLERS LOG

3-9 1971 Bumpass Well Co. Marshall
 date well completed Dean + Kent Bumpass firm name county well located

LANDOWNER:
Arthur Ellin
at 2 waterford miss
(mailing address)

description of formations encountered	from	to
<u>clay</u>	<u>0</u>	<u>20</u>
<u>sand</u>	<u>20</u>	<u>260</u>

WELL LOCATION:
sec. 19 T. 5 N. R. 3 E
3 miles north of Lava Hill
(distance) (direction) (nearest town)

WELL PURPOSE: water
(home, irrigation, municipal, industrial)

WELL COMPLETION DATA:
 (1) diameter (inches) 4"
 (2) total depth (feet) 260 feet
 (3) static water level (feet) 180 below above top of ground.
 (4) casing PVC, 260 feet
 (material) (depth)
 (size) If telescope see back.
 (5) screen 6 feet, 25 4
 (length) (depth to top)
4", gravel well
 (size) (material)
 (6) pump 1 1/2 20
 (HP) (yield gpm)

CODED

(type power)
 (7) electric log elect
 (yes or no)
 (organization running log)
 (8) how well bottom plugged 4" cap


APR 19 1971

MISS. BD. OF
WATER COMM.

DRILLERS REMARKS:

If well telescopes please
sketch and show depths.

GROUND LEVEL

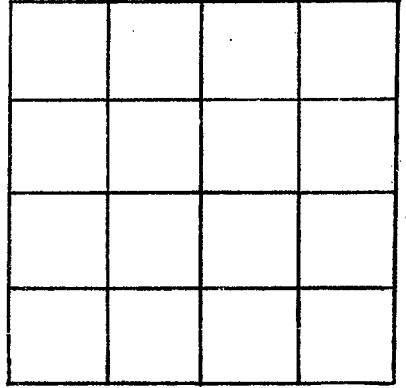

SECTION _____

Please indicate well location X.

ADDITIONAL INFORMATION

If more than one screen,
show locations of each on sketch.