

MARSHAL  
513  
10-4-71

MISSISSIPPI  
BOARD OF WATER COMMISSIONERS  
416 North State Street  
Jackson, Mississippi 39201

WATER WELL DRILLERS LOG

10-4 1971 Dean F. Bumpas Wellers Marshall  
date well completed firm name county well located

LANDOWNER:  
Mary Haffner  
St 5 - Box 234 Holly Springs, Miss  
(mailing address)

description of formations encountered  
clay **CODED** from 20 to 20  
Sand **CODED** from 20 to 220

WELL LOCATION:  
sec. 10 T. 5 N. R. 3 E.  
16 miles S of Holly Springs  
(distance) (direction) (nearest town)

WELL PURPOSE: Domestic  
(home, irrigation, municipal, industrial)

- WELL COMPLETION DATA:
- (1) diameter (inches) 4"
  - (2) total depth (feet) 220 feet
  - (3) static water level (feet) 160 feet below above top of ground.
  - (4) casing PVC, 220 feet (material) (depth)  
(size) If telescope see back.
  - (5) screen 16 ft., 214 ft. (length) (depth to top)  
4" gravel wail (size) (material)
  - (6) pump 3/4, 10 (HP) (yield gpm)  
(type power)
  - (7) electric log elect (yes or no)  
(organization running log)
  - (8) how well bottom plugged 4" cap.

**CODED**


OCT 7 - 1971

DRILLERS REMARKS:

MISS. Bd. of  
WATER COMMISSIONERS

If well telescopes please sketch and show depths.

GROUND LEVEL

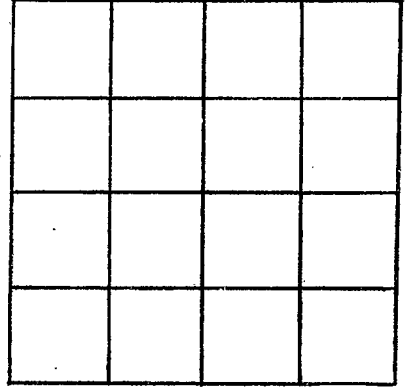

SECTION \_\_\_\_\_

Please indicate well location X.

ADDITIONAL INFORMATION

If more than one screen,  
show locations of each on sketch.