

Marshall
516
6-68

MISSISSIPPI
BOARD OF WATER COMMISSIONERS
416 North State Street
Jackson, Mississippi 39201

CODED

WATER WELL DRILLERS LOG

June 24 1968 Rayson Well Co Marshall
date well completed firm name county well located

LANDOWNER: John C. Pusey
Pusey

description of formations encountered

from	to
0	18
18	190

Waterford Miss
(mailing address)

Red Clay
son


WELL LOCATION:
sec. 31 T-5 N R-3 E
2 miles N-E of Law Hill
(distance) (direction) (nearest town)

WELL PURPOSE: Dwelling House
(home, irrigation, municipal, industrial)

WELL COMPLETION DATA:

- (1) diameter (inches) 4"
- (2) total depth (feet) 190
- (3) static water level (feet) 130 ^{below}/_{above} top of ground.
- (4) casing plastic, 124 ft.
(material) (depth)
no if telescope see back.
(size)
- (5) screen 6 ft., 124 ft.
(length) (depth to top)
008, granite well
(size) (material)
- (6) pump 3/4, 10 gal
(HP) (yield gpm)
Elect.
(type power)
- (7) electric log no
(yes or no)
no
(organization running log)
- (8) how well bottom plugged plastic plug


CODED

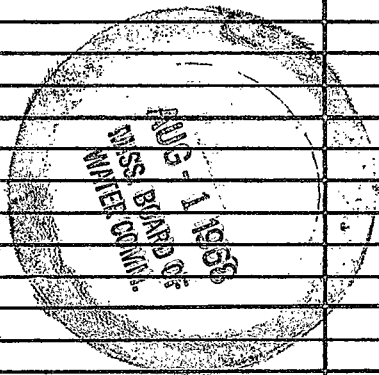

DRILLERS REMARKS:

If well telescopes please sketch and show depths.

GROUND LEVEL

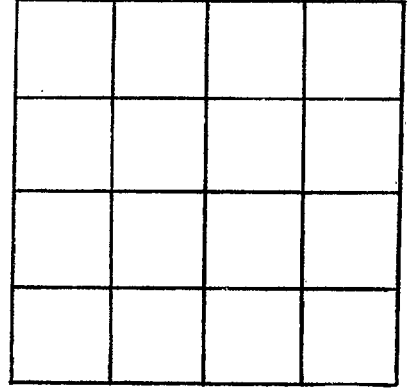

SECTION _____

Please indicate well location X.

ADDITIONAL INFORMATION

If more than one screen, show locations of each on sketch.