

Marshall
 517
 8-68

MISSISSIPPI
 BOARD OF WATER COMMISSIONERS
 416 North State Street
 Jackson, Mississippi 39201

CODED

WATER WELL DRILLERS LOG

Aug 19 1968 Pumps Well Co Marshall
 date well completed firm name county well located

LANDOWNER: L. G. Cury
 Waterford Miss
 (mailing address)


description of formations encountered	from	to
	Clay Sand	0 30

WELL LOCATION:
 sec. 26 T. 5 N. R. 3 E
 2 1/2 miles S of Waterford
 (distance) (direction) (nearest town)

WELL PURPOSE:
 (home, irrigation, municipal, industrial)

- WELL COMPLETION DATA:
- (1) diameter (inches) 4"
 - (2) total depth (feet) 170
 - (3) static water level (feet) 100 ^{below}/_{above} top of ground.
 - (4) casing 4" plastic 163
 (material) (depth)
 - 4" if telescope see back
 (size)
 - (5) screen 7' galv. wall 163 ft
 (length) (depth to top)
 - 4" PVC plastic
 (size) (material)
 - (6) pump 3/4 10
 (HP) (yield gpm)
 - Chafe
 (type power)
 - (7) electric log _____
 (yes or no)
 - _____ (organization running log)
 - (8) how well bottom plugged # cap


CODED

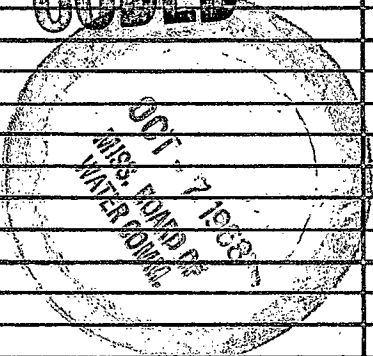

DRILLERS REMARKS:

If well telescopes please
sketch and show depths.

GROUND LEVEL

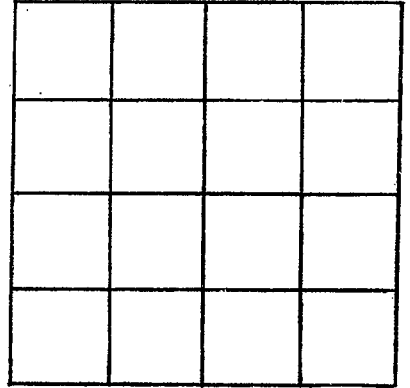

SECTION _____

Please indicate well location X.

ADDITIONAL INFORMATION

If more than one screen,
show locations of each on sketch.