

MARSHALL
S 22
1-18-73

MISSISSIPPI
 BOARD OF WATER COMMISSIONERS
 416 North State Street
 Jackson, Mississippi 39201

CODED

WATER WELL DRILLERS LOG

1-18 date well completed 1973 DEAD + Kent Bumpas well Co. firm name MARSHALL county well located

LANDOWNER: Kevin Ellen
Los Hill
 (mailing address)

description of formations encountered	from	to
	<u>clay</u>	<u>0</u>
<u>sand</u>	<u>30</u>	<u>70</u>
<u>clay</u>	<u>70</u>	<u>90</u>
<u>sand</u>	<u>90</u>	<u>180</u>

WELL LOCATION:
 sec 31 T 5 N R 3 E
3 miles N.E. of Los Hill
 (distance) (direction) (nearest town)

WELL PURPOSE: Dwellings
 (home, irrigation, municipal, industrial)

WELL COMPLETION DATA:

(1) diameter (inches) 4"

(2) total depth (feet) 180 feet

(3) static water level (feet) 140 below above top of ground.

(4) casing PVC 180 feet
 (material) (depth)
 (size) If telescope see back.

(5) screen 7ft. 17.3 feet
 (length) (depth to top)
4" GRAVEL
 (size) (material)

(6) pump 3/4 14
 (HP) (yield' gpm)
 (type power)

(7) electric log Elect
 (yes or no)
 (organization running log)

(8) how well bottom plugged 4" cap


CODED

DRILLERS REMARKS:

FEB 5 1973

If well telescopes please sketch and show depths.

GROUND LEVEL

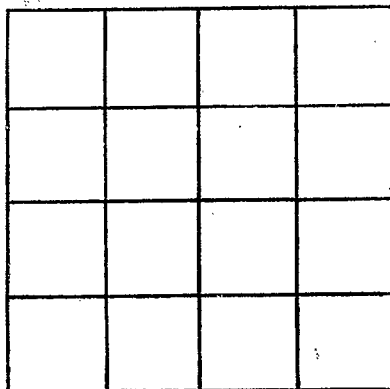

SECTION _____

Please indicate well location X.

ADDITIONAL INFORMATION

If more than one screen, show locations of each on sketch.