

MARSHALL

523

3-30-73

MISSISSIPPI BOARD OF WATER COMMISSIONERS  
416 North State Street  
Jackson, Mississippi 39201

WATER WELL DRILLERS LOG

CODED

3-30

date well completed

1973

*Don't forget bumper stickers*  
firm name

*Marshall*  
county well located

LANDOWNER:	description of formations encountered	from	to
<i>Shullie Bea Harris</i>			
<i>LOS HILL</i> (mailing address)	<i>Sand</i>	<i>20</i>	<i>70</i>
WELL LOCATION:	<i>Clay</i>	<i>70</i>	<i>90</i>
sec. <i>32</i> T <i>5</i> N R <i>3</i> E	<i>Sand</i>	<i>90</i>	<i>200</i>
<i>3</i> miles <i>NORTH EAST</i> of <i>LAWS HILL</i> (distance) (direction) (nearest town)			
WELL PURPOSE: <i>Dwelling</i> (home, irrigation, municipal, industrial)			
WELL COMPLETION DATA:			
(1) diameter (inches) <i>4"</i>			
(2) total depth (feet) <i>200 feet</i>			
(3) static water level (feet) <i>130 feet</i> <sup>below</sup> / <sub>above</sub> top of ground.			
(4) casing <i>PVC 200 feet</i> (material) (depth)			
(size) if telescope see back.			
(5) screen <i>7 ft.</i> <i>19 3 feet</i> (length) (depth to top)			
<i>4"</i> <i>gravel wrap</i> (size) (material)			
(6) pump <i>3/4</i> <i>14</i> (HP) (yield/gpm)			
(type power)			
(7) electric log <i>slat.</i> (yes or no)			
(organization running log)			
(8) how well bottom plugged <i>4" cap.</i>			
DRILLERS REMARKS:			


CODED

ADD A ...

...

If well telescopes please sketch and show depths.

GROUND LEVEL

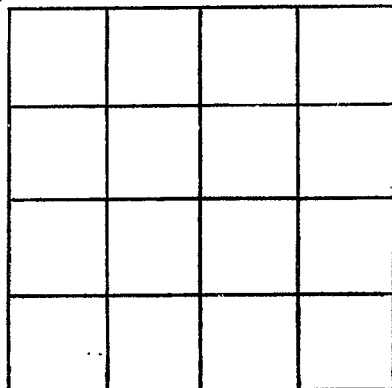

SECTION \_\_\_\_\_

Please indicate well location X.

ADDITIONAL INFORMATION

If more than one screen,  
show locations of each on sketch.