

MISSISSIPPI
BOARD OF WATER COMMISSIONERS
 416 North State Street
 Jackson, Mississippi 39201

CODED

WATER WELL DRILLERS LOG

MARSHALL
S 24
3-26-73

3-26 1973 Dean Kent Bumpers well Marshall
 date well completed firm name county well located

LANDOWNER:
Liggett M. Ingram
At. Waterford miss
 (mailing address)

description of formations encountered	from	to
<u>clay</u>	<u>0</u>	<u>20</u>
<u>Sand</u>	<u>20</u>	<u>170</u>

WELL LOCATION:
 sec 26 T. 5 N. R. 3 E.
4 miles South of Waterford
 (distance) (direction) (nearest town)

WELL PURPOSE: Dwelling
 (home, irrigation, municipal, industrial)

CODED


- WELL COMPLETION DATA:**
- (1) diameter (inches) 4"
 - (2) total depth (feet) 170 feet
 - (3) static water level (feet) 154 below above top of ground.
 - (4) casing PVC, 170 feet
 (material) (depth)
 (size) If telescope see back.
 - (5) screen 20", 163 feet
 (length) (depth to top)
4" Gravel wash
 (size) (material)
 - (6) pump 3/4, 14
 (HP) (yield gpm)
 (type power)
 - (7) electric log clay
 (yes or no)
 (organization running log)
 - (8) how well bottom plugged 4' conf.

DRILLERS REMARKS:

APR 6 1973

If well telescopes please sketch and show depths.

GROUND LEVEL

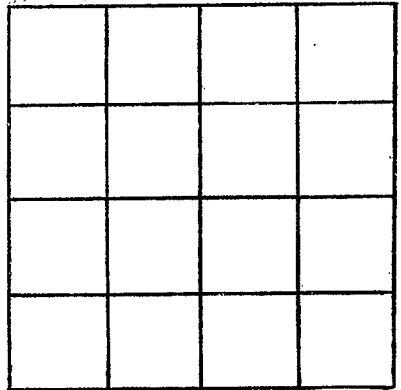

SECTION _____

Please indicate well location X.

ADDITIONAL INFORMATION

If more than one screen,
show locations of each on sketch.