

MARSHALL

525

4-17-73

MISSISSIPPI BOARD OF WATER COMMISSIONERS  
416 North State Street  
Jackson, Mississippi 39201

CODER

WATER WELL DRILLERS LOG

4-17-1973 date well completed  
Licks Bros Well firm name  
Marshall county well located

LANDOWNER: <u>Jerry</u>	description of formations encountered	from	to
<u>Widson - Route 5</u>	<u>Red Clay</u>	<u>0</u>	<u>15</u>
<u>Holly Springs, Miss</u> (mailing address)	<u>Red Sand</u>	<u>15</u>	<u>70</u>
WELL LOCATION:	<u>Red Sand &amp; white clay</u>	<u>70</u>	<u>100</u>
sec. <u>5</u> T. <u>5</u> N. R. <u>3</u> E.	<u>Red Sand</u>	<u>100</u>	<u>120</u>
<u>8</u> miles <u>NW</u> of <u>H.S.</u>	<u>White Sand</u>	<u>120</u>	<u>190</u>
(distance) (direction) (nearest town)	<u>Black Clay</u>	<u>190</u>	<u>200</u>
WELL PURPOSE: <u>Home</u> (home, irrigation, municipal, industrial)	<u>White Sand</u>	<u>200</u>	<u>220</u>
WELL COMPLETION DATA:			
(1) diameter (inches) <u>4 in.</u>			
(2) total depth (feet) <u>220</u>			
(3) static water level (feet) <u>164</u> below top of ground.			
(4) casing <u>Plastic</u> , <u>220</u> (material) (depth)			
_____ if telescope see back. (size)			
(5) screen <u>4 ft.</u> , <u>216</u> (length) (depth to top)			
<u>4 in.</u> , <u>Gravel</u> (size) (material)			
(6) pump <u>3/4</u> , <u>10</u> (HP) (yield gpm)			
<u>Electric</u> , <u>220</u> (type power)			
(7) electric log <u>no</u> (yes or no)			
_____ (organization running log)			
(8) how well bottom plugged <u>Cap</u>			
DRILLERS REMARKS:			

CODER


APR 20 1973  
APR 20 1973

If well telescopes please sketch and show depths.

Blank area for sketching well telescopes and showing depths.

GROUND LEVEL

Large blank vertical area for sketching well details and depths.

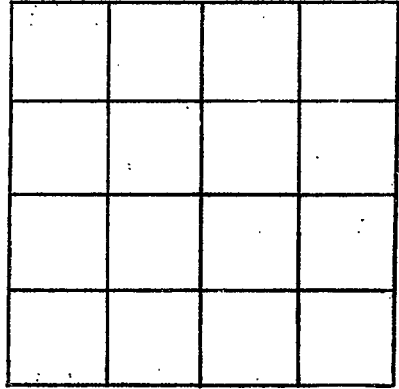

SECTION \_\_\_\_\_

Please indicate well location X.

ADDITIONAL INFORMATION

Lined area for providing additional information, possibly a log of observations or measurements.

If more than one screen, show locations of each on sketch.

Blank area for sketching multiple screen locations when more than one is present.