

**MARSHALL**  
**S 26**  
**5-28-73**

MISSISSIPPI  
 BOARD OF WATER COMMISSIONERS  
 416 North State Street  
 Jackson, Mississippi 39201

**CODED**

**WATER WELL DRILLERS LOG**

5-28-1973 B. Hinkley, W.M.O. Marshall  
 date well completed firm name county well located


LANDOWNER: <u>Anna</u>	description of formations encountered	from	to
<u>Miss - Rt 5,</u> <u>Holly Springs Miss.</u> (mailing address)	<u>Red Clay</u>	<u>0</u>	<u>15</u>
	<u>Red Sand</u>	<u>15</u>	<u>30</u>
	<u>White Clay &amp; Red Sand</u>	<u>30</u>	<u>60</u>
	<u>Red Sand</u>	<u>60</u>	<u>90</u>
	<u>White Sand</u>	<u>90</u>	<u>140</u>
	<u>White Sand &amp; Clay</u>	<u>140</u>	<u>210</u>
	<u>White Sand</u>	<u>210</u>	<u>250</u>
WELL LOCATION: sec. <u>18</u> T. <u>5</u> N. R. <u>3</u> E. <u>10</u> miles <u>W</u> of <u>Holly Springs</u> (distance) (direction) (nearest town)			
WELL PURPOSE: <u>Home</u> (home, irrigation, municipal, industrial)			
WELL COMPLETION DATA:			
(1) diameter (inches) <u>4 1/2</u> inch			
(2) total depth (feet) <u>250</u>			
(3) static water level (feet) <u>166</u> below top of ground.			
(4) casing <u>Plastic</u> , <u>250</u> (material) (depth)			
_____ If telescope see back. (size)			
(5) screen <u>4 ft</u> , <u>251</u> (length) (depth to top)			
<u>4 hr</u> , <u>Gravel</u> (size) (material)			
(6) pump <u>3/4</u> <u>10 GPM</u> (HP) (yield gpm)			
<u>Electric</u> <u>250</u> (type power)			
(7) electric log <u>NO</u> (yes or no)			
_____ (organization running log)			
(8) how well bottom plugged <u>Cap</u>			
DRILLERS REMARKS:			

**CODED**

JUN 15 1973

If well telescopes please sketch and show depths.

GROUND LEVEL

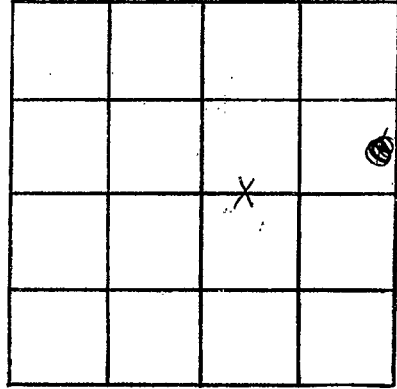

SECTION 18

Please indicate well location X.

ADDITIONAL INFORMATION

If more than one screen,  
show locations of each on sketch.