

LOCATION?

MARSHALL
528
4-27-73

MISSISSIPPI
BOARD OF WATER COMMISSIONERS
416 North State Street
Jackson, Mississippi 39201

CODED

WATER WELL DRILLERS LOG

4-27
date well completed

1973 Atkinson + Fred Marshall
firm name

county well located

LANDOWNER:

Odell Davis

description of formations encountered

from to

RHS Holly Springs
(mailing address)

Clay 0 12
Shale 12 80
white sand 80 120

WELL LOCATION:

sec. 4 T. 5 N. R. 3 E. 3
6 miles NE of Chulahoma
(distance) (direction) (nearest town)

WELL PURPOSE:

home
(home, irrigation, municipal, industrial)

WELL COMPLETION DATA:

- (1) diameter (inches) 4"
- (2) total depth (feet) 120
- (3) static water level (feet) 85 below above top of ground.
- (4) casing P.V.C. 110
(material) (depth)
(size) if telescope see back.
- (5) screen 10 110
(length) (depth to top)
4" P.V.C.
(size) (material)
- (6) pump 1/2 10
(HP) (yield gpm)
elec
(type power)
- (7) electric log NO
(yes or no)

CODED

(organization running log)


(8) how well bottom plugged CMP

DRILLERS REMARKS:

JUN 6 1973

If well telescopes please sketch and show depths.

GROUND LEVEL

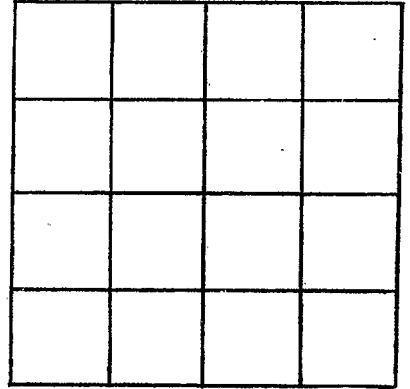

SECTION _____

Please indicate well location X.

ADDITIONAL INFORMATION

If more than one screen,
show locations of each on sketch.