

MARSHALL
S 29
3/74

MISSISSIPPI
 BOARD OF WATER COMMISSIONERS
 416 North State Street
 Jackson, Mississippi 39201

CODED

WATER WELL DRILLERS LOG

Atkinson & Frost **Marshall**
 firm name county well located

date well completed

firm name

county well located

LANDOWNER:

Mary Dean
Waterford Miss
 (mailing address)

description of formations encountered

from to

<i>Red Clay</i>	<i>0</i>	<i>20</i>
<i>Red Sand</i>	<i>20</i>	<i>30</i>
<i>White Sand</i>	<i>30</i>	<i>60</i>

WELL LOCATION:

sec. 5 T. 5 N. R. 3 E.
 (S) (W)
3 miles South of Waterford
 (distance) (direction) (nearest town)

WELL PURPOSE:

(home, irrigation, municipal, industrial)

WELL COMPLETION DATA:

- (1) diameter (inches) 4 1/2
- (2) total depth (feet) 60
- (3) static water level (feet) 38 below above top of ground.
- (4) casing (material) _____ (depth) _____
 _____ if telescope see back.
 (size)
- (5) screen 52 60
 (length) (depth to top)
4 PVC
 (size) (material)
- (6) pump 1/2 10
 (HP) (yield gpm)
Elec
 (type power)
- (7) electric log (yes or no) _____

CODED

(organization running log)

(8) how well bottom plugged _____


RECEIVED
FEB 27 1974

DRILLERS REMARKS:

MISS. BD OF WATER COMMISSIONERS

If well telescopes please sketch and show depths.

GROUND LEVEL

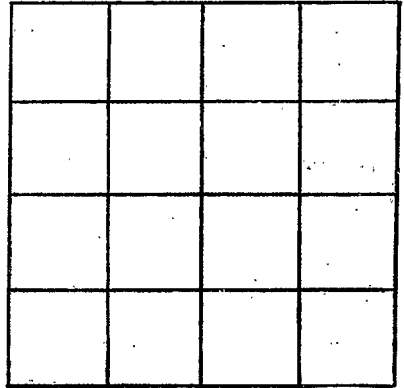

SECTION _____

Please indicate well location X.

ADDITIONAL INFORMATION

A series of horizontal lines providing space for additional information.

If more than one screen, show locations of each on sketch.