

MARSHALL

S30

4-2-74

OF WATER COMMISSIONERS
416 North State Street
Jackson, Mississippi 39201

WATER WELL DRILLERS LOG

4-2 date well completed 1974 Dean + Katherine Marshall firm name Marshall county well located

LANDOWNER:

J. B. Byers

pt 2, Bk 13 waterfordsville
(mailing address)

description of formations encountered

clay
sand

from to

0 30
30 160

WELL LOCATION:

sec. 28 T 5 N R 3 E
5 miles S.W. of Waterford
(distance) (direction) (nearest town)

WELL PURPOSE: Domestic
(home, irrigation, municipal, industrial)

WELL COMPLETION DATA:

- (1) diameter (inches) 4"
- (2) total depth (feet) 160 feet
- (3) static water level (feet) 60 feet below top of ground.
- (4) casing PVC, 160 feet (material) (depth)

(size) If telescope see back.

- (5) screen 7 ft., 153 feet (length) (depth to top)

4" gravel wall (size) (material)

- (6) pump 3/4 (HP) 14 (yield/gpm)


(type power)

- (7) electric log Elect. (yes or no)

(organization running log)

- (8) how well bottom plugged 4' Conf.

DRILLERS REMARKS:

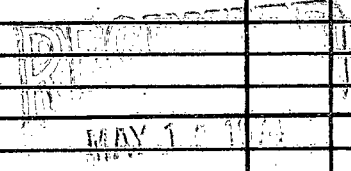

MISS. BLD. OF WATER COMMISSIONERS

