

**MARSHALL**  
**S32**  
**5-3-74**

MISSISSIPPI  
 BOARD OF WATER COMMISSIONERS  
 416 North State Street  
 Jackson, Mississippi 39201 **CODED**

**WATER WELL DRILLERS LOG**

5-3 1974 Dead Heart Pump Wells **MARSHALL**  
 date well completed firm name county well located


LANDOWNER:	description of formations encountered	from	to
<u>BOBBY BING</u>		<u>Clay</u>	<u>0</u>
<u>WATERFORD, MISS.</u> (mailing address)	<u>Sand</u>	<u>20</u>	<u>130</u>
<b>WELL LOCATION:</b>			
sec <u>23</u> T <u>5</u> N R <u>3</u> E			
<u>2</u> miles <u>S.W.</u> of <u>WATERFORD</u>			
(distance) (direction) (nearest town)			
<b>WELL PURPOSE:</b> <u>Dwellings</u> (home, irrigation, municipal, industrial)			
<b>WELL COMPLETION DATA:</b>			
(1) diameter (inches) <u>4"</u>			
(2) total depth (feet) <u>130 feet</u>			
(3) static water level (feet) <u>50 feet</u> <sup>below</sup> above top of ground.			
(4) casing <u>pvc</u> <u>130 feet</u> (material) (depth)			
<u>      </u> if telescope see back. (size)			
(5) screen <u>7 ft.</u> <u>123 feet</u> (length) (depth to top)			
<u>4"</u> <u>30 AU CL WALL</u> (size) (material)			
(6) pump <u>3/4</u> <u>14</u> (HP) (yield gpm)			
<u>      </u> (type power)			
(7) electric log <u>slat</u> (yes or no)			
<u>      </u> (organization running log)			
(8) how well bottom plugged <u>4" cap</u>			
<b>DRILLERS REMARKS:</b>			

**CODED**

June 12 1974

telescopes please  
sketch and show depths.

GROUND LEVEL

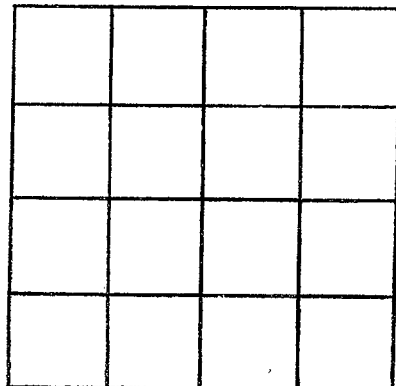

SECTION \_\_\_\_\_

Please indicate well location X.

ADDITIONAL INFORMATION

If more than one screen,  
show locations of each on sketch.