

MARSHALL
S35
9/26/74

MISSISSIPPI
BOARD OF WATER COMMISSIONERS
416 North State Street
Jackson, Mississippi 39201 CODED

WATER WELL DRILLERS LOG

9-26-1974 date well completed
Dean Kent Benjamin firm name
Marshall county well located

LANDOWNER:	description of formations encountered	from	to
Lama B. Turnage		clay	0
P.O. Box 442, Waterford Miss (mailing address)	sand	20	70
WELL LOCATION:	clay	70	75
sec. 26 T-5 N R-3 E 4 miles South of Waterford (distance) (direction) (nearest town)	sand	75	187

CODED

WELL PURPOSE: drinking
(home, irrigation, municipal, industrial)

- WELL COMPLETION DATA:
- (1) diameter (inches) 4"
 - (2) total depth (feet) 187 feet
 - (3) static water level (feet) 143 below above top of ground.
 - (4) casing PVC, 187 feet
(material) (depth)
 - _____ If telescope see back.
(size)
 - (5) screen 7 ft., 180 feet
(length) (depth to top)
 - 4", gravel w all
(size) (material)
 - (6) pump 3/4, 14
(HP) (yield gpm)
 - _____ (type power)
 - (7) electric log elect.
(yes or no)
 - _____ (organization running log)
 - (8) how well bottom plugged 4" cap.


RECEIVED
OCT 10 1974

DRILLERS REMARKS:

MISS. BD. OF WATER COMMISSIONERS

If well telescopes please sketch and show depths.

GROUND LEVEL

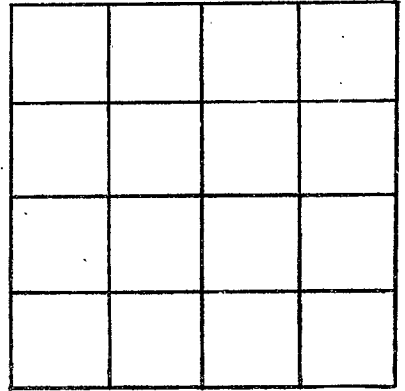

SECTION _____

Please indicate well location X.

ADDITIONAL INFORMATION

If more than one screen,
show locations of each on sketch.