

MISSISSIPPI DEPARTMENT OF NATURAL RESOURCES

Bureau of Land and Water Resources

Southport Mall

P.O. Box 10631

Jackson, Mississippi 39209

WATER WELL DRILLERS LOG

CODED

S-39
MARSHALL
6-17-80

6-17 1980 date well completed
Rich W. Allen firm name
Marshall county well located

LANDOWNER:	description of formations encountered	from	to
Calven Perry Rt. 5, Zully Springs (mailing address)	Clay	0	30
WELL LOCATION: sec. 7 T. 5 N. R. 3 E Blake S W miles of (distance) (direction) (nearest town)	Red sand	30	110
	white sand	110	245
WELL PURPOSE: (home, irrigation, municipal, industrial)	CODED		
WELL COMPLETION DATA:			
(1) diameter (inches) 4 in			
(2) total depth (feet) 275			
(3) static water level (feet) 120 below top of ground.			
(4) casing Plastic 275 (material) (depth) if telescope see back. (size)			
(5) screen 7 ft 238 (length) (depth to top) 4 in Gravel (size) (material)			
(6) pump 1/2 170 (HP) (yield gpm) 220 (type power) 10			
(7) electric log No (yes or no) (organization running log)			
(8) how well bottom plugged Cop			
DRILLERS REMARKS:			


DEPT. OF NATURAL RESOURCES
BUREAU OF LAND & WATER RESOURCES

SEP 4 - 1980

RECEIVED

If well telescopes please sketch and show depths.

GROUND LEVEL

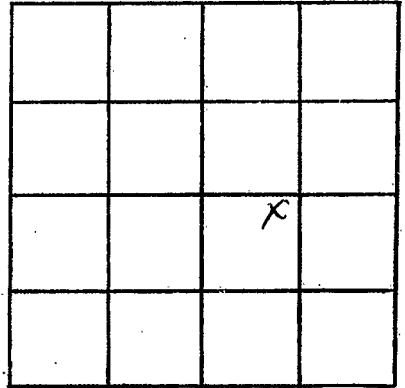

SECTION 1

Please indicate well location X.

ADDITIONAL INFORMATION

If more than one screen,
show locations of each on sketch.