	State Well Report		
County: Marshall	Part 1 – Driller's Log	For Office Use Only:	
1	Mississippi Department of Environmental	Quality Aquifer:	
Permit #:	Office of Land and Water Resource	s Well #: 565	
Driller: Jones W. Mason	P.O. Box 2309 Jackson, MS 39225		
	(601)961- 5210	L. S. Elevation:	
Date drilling completed: (0 - 18 - 12	(601)961- 5228 (fax)	E-log #:	
State I aw requires that this repor	t be prepared by the license holder respon		
	within 30 days of completion of drilling o		
Information on Well O		Well or Borehole Location	
(Landowner if borehole is not fo	r a water well)	0% 4 × 00 CPG 1	
Owner Name Bobby Hell	Latitude: 34° ° ° ° ° ° ° ° ° ° ° ° ° ° ° ° ° ° °	Longitude: 010 3 (,000 "	
Mailing Address: 1312 Tho	Method of Lat/Long	Longitude: $\frac{89}{6} \cdot \frac{54}{32}$, Longitude: $\frac{89}{32} \cdot \frac{54}{56}$, Gircle one): Conventional Survey,	
Mailing Address: 10 (2 1 %)	USGS quad,	Hand-held GPS, Survey-grade GPS	
() to stock on	NE WNEW	Sec 31 Twn 55 Rng 365	
City State	e Zip Code Distance D	irection Nearest Town	
Telephone No. (101) 338-040	Miles N	JE of Lows Hill	
····	Well / Borehole Data		
0 Ai - Ot		(3)	
Date drilling started: Date dri	lling completed: $(0 - 8)$ Hole depth: $\frac{9}{}$	Hole diameter: (0) 14	
Location of the source of any surface water Method of dosing and volume of Chlorine	used for drilling: NA used in drilling and development: NA		
Logs run (circle all applicable): No log run Electric Gamma Ray Density Sonic Neutron Other: Name of organization running log(s):			
Purpose of borehole (check one): Water We	ell <u> </u>	Ground Source Heat Pump	
Seismic S	urveyOther (describe)		
If drilling is not related to water well construction, skip the remainder of this block			
Purpose of Well (check one): Home Industrial Public Supply Irrigation Fish Culture Other:			
If a flowing well, method of flow regulation: Valve Other (describe)			
Static Water Level: 135 feet above or below circle one) land surface Date measured: 10-19-12			
Method of Measurement (circle one) steel tape electric tape air line other: String (weight			
Well depth: 345 Well grouted to a depth of 10 feet Type of grout (circle one): Neat Cement Bentonite Mix			
Casing length:			
Screen length: 30 feet Screen diameter: 4 inches Type of screen: PVC			
Screen slot size:,OIDinches Setting depth: From			
Type of completion (circle all applicable): Gravel packed Underreamed Telescoped Open hole Natural Development			
Other (describe):			

Top of lap pipe or reduction in casing: _

Form: OLWR SWR 19 10 10 10 10

feet. If telescoped or more than one screen, describe on next page




The	sketch	below	only	required	for	water	wells

If well telescopes, show depths on sketch. Ground Level-

Description of formations encountered must be provided for all wells and boreholes, unless specifically exempted by regulations

Description of Formations Encountered	From (depth)	To (depth)
Description of Formations Encountered	Ground Level	30
white clay	30	65
white Sold.	65	245
	I	
		<u></u>
		<u> </u>

If more than one screen, show location of each on sketch

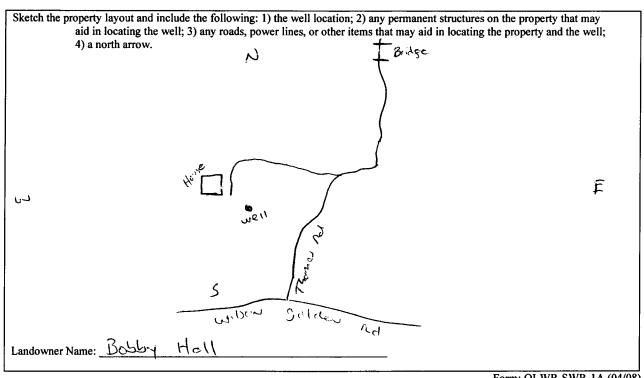

Form: OLWR-SWR-1A (04/08)

I certify that the well/borehole was drilled, constructed, and completed in accordance with all applicable requirements of the Mississippi Department of Environmental Quality and the Mississippi Department of Health regulations, if applicable, and state

laws.			
Dares W. Maron 0-63	11-15-12	Jeso W Mon	DECEME
Print Name of Responsible Licensee and Licens	e No. Date	Signature of Licensee	MOV 2 9 2012

STATE WELL REPORT

Permit #: Driller: Jones W. Meson Date completed: (0 - 19 - 12 Copy information from block on Part 1

Part 2

Pump Installer's Completion Report
Mississippi Department of Environmental Quality
Office of Land and Water Resources
P.O. Box 2309
Jackson, MS 39225

For Office Use Only:		
Aquifer:		
Well #:	565	
Elevation:		

(601)961-5210 (601)961-5228 (fax) Copy information from block on Part 1 This part of the report must be completed by a licensed water well contractor or a licensed pump installer. A copy of Part 1 of the report must be attached and both parts filed with the Department at the above address within 30 days of well completion. Well Owner Information Latitude: 34,61.247 Longitude: 89.54-880 Owner Name: Bobby Hall Method of Lat/Long (check one): Conventional Survey____, Mailing Address: USGS quad ___, Hand-held GPS____, Survey-grade GPS____ NE 1/2 NE 1/2 Sec 3/ T 55 R 3 W Distance Direction Nearest Town 2 Miles NE of Laws Hill Telephone No. (901) 338-0406 Power Type Pump Type Circle one Circle one Air Lift Submersible Diesel Engine Gasoline Engine Natural Gas **Jet Tractor PTO** Electric Motor Hand Piston Turbine Bucket Other (specify): Windmill Centrifugal Rotary Flowing Well Horse Power Rating of Motor: 1 40 Other (specify): Setting Depth: _______ i 60 _____feet Number of Stages: ____ Rated Pump Capacity: ______ Gallons Per Minute Method of Measuring Water Level Pump Test Data Circle one Date Well Tested: 10-19-12 Air Line Electric Measuring Line Steel Tape Static Water Level (A): 135 Feet Below Land Surface Other (specify): String lueight Pumping Water Level (B): Feet Below Land Surface Drawdown [(B) - (A)]: ______Feet Below Land Surface For flowing well, measured shut in head: Well yielded _ () Test Pumping Rate: _____ (C _____ Gallons Per Minute GPM with a drawdown of feet after $\frac{\partial \mathcal{V}}{\partial \mathbf{v}}$ hours of pumping Duration of Pump Test (minimum 4 hours): _______ hours

I HEREBY CERTIFY that the above statements are true to the best	of my knowledge.
Jones W. Majon 0-620	yeur w. Men
Print Name of Pump Installer and License No. (if applicable)	Signature of Pump Installer
Time traine of a unity mount in a distance in the Car appropriate in the care	Form: OLWR-SWR-1B (04/08)

BY OLWA