

Marshall
S 2000
6-15-76

MISSISSIPPI
 BOARD OF WATER COMMISSIONERS
 416 North State Street
 Jackson, Mississippi 39201

WATER WELL DRILLERS LOG


6-15 1976 Hicks Well Co Marshall
 date well completed firm name county well located

LANDOWNER: <u>Henry Lee Culver</u> <u>Rt. 2</u>	description of formations encountered	from	to
<u>Waterford, Miss.</u> (mailing address)	<u>Red clay</u> <u>Sand</u> <u>White Sand</u>	<u>0</u> <u>10</u> <u>100</u>	<u>10</u> <u>100</u> <u>220</u>
WELL LOCATION: sec. <u>22</u> <u>5</u> <u>N</u> R. <u>3</u> <u>E</u> <u>5</u> miles <u>SW</u> of <u>Waterford</u> (distance) (direction) (nearest town)			
WELL PURPOSE: <u>Home</u> (home, irrigation, municipal, industrial)			
WELL COMPLETION DATA: (1) diameter (inches) <u>4"</u> (2) total depth (feet) <u>220</u> (3) static water level (feet) _____ below/above top of ground. (4) casing <u>PVC</u> , <u>220</u> , (material) (depth) _____ if telescope see back. (size) (5) screen <u>4"</u> , <u>216</u> (length) (depth to top) <u>4"</u> , <u>Steel</u> (size) (material) (6) pump <u>1/2</u> , <u>10</u> (HP) (yield gpm) <u>220</u> (type power) (7) electric log <u>NO</u> (yes or no) _____ (organization running log) (8) how well bottom plugged <u>Cap</u>			
DRILLERS REMARKS:			

RECEIVED
 JUN 15 1976
 MISSISSIPPI BOARD OF WATER COMMISSIONERS

If well telescopes please sketch and show depths.

GROUND LEVEL

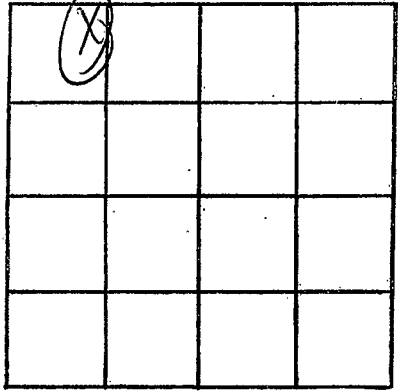

SECTION 27

Please indicate well location X.

ADDITIONAL INFORMATION

If more than one screen, show locations of each on sketch.