

Marshall  
 S 2003  
 8/1/77  
 19

MISSISSIPPI  
 BOARD OF WATER COMMISSIONERS  
 416 North State Street  
 Jackson, Mississippi 39201

WATER WELL DRILLERS LOG

*Walker*  
*Walker*  
 Marshall

date well completed

firm name

county well located

LANDOWNER: *Willie*

*Walker R#5*

*Sally Spurr*  
 (mailing address)

description of formations encountered

from

to

CLAY	0	25
Red SAND	25	75
White CLAY	75	140
SAND & CLAY MIX	140	200
White SAND	200	250


WELL LOCATION:

sec. 4 T. 5 N. R. 3 E.  
5 miles NE of Chalmette  
 (distance) (direction) (nearest town)

WELL PURPOSE: *Home*  
 (home, irrigation, municipal, industrial)

WELL COMPLETION DATA:

- (1) diameter (inches) 4 1/2
- (2) total depth (feet) 250
- (3) static water level (feet) 180 below top of ground.
- (4) casing PVC 250  
 (material) (depth)
- (size) If telescope see back.
- (5) screen 10' 240  
 (length) (depth to top)
- 4" PVC  
 (size) (material)
- (6) pump 3/4 10  
 (HP) (yield gpm)
- Elec  
 (type power)
- (7) electric log NO  
 (yes or no)

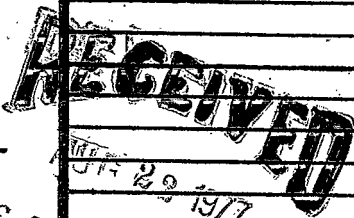


(organization running log)

(8) how well bottom plugged caps

DRILLERS REMARKS:

If well telescopes please sketch and show depths.

GROUND LEVEL

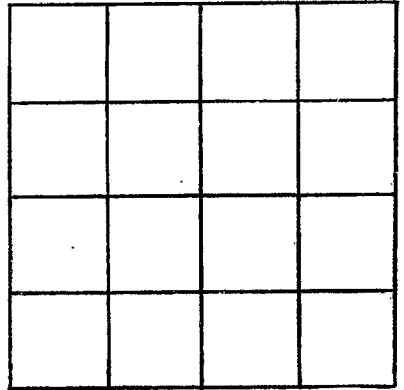

SECTION \_\_\_\_\_

Please indicate well location X.

ADDITIONAL INFORMATION

If more than one screen, show locations of each on sketch.