

Marshall
S 2004
11/15/77

MISSISSIPPI
BOARD OF WATER COMMISSIONERS
416 North State Street
Jackson, Mississippi 39201

WATER WELL DRILLERS LOG

11-15-1977 Kicks Well Co. Marshall
date well completed firm name county well located

LANDOWNER: Wilson Reynolds
Rt. 3
Holly Springs, Mo.
(mailing address)

description of formations encountered	from	to
Red clay	0	15
Red clay + sand	15	100
Red sand	100	160
White sand	160	230


WELL LOCATION:
sec. 9 T. 5 N R. 3 E
3 miles E. of Dalema
(distance) (direction) (nearest town)

WELL PURPOSE: Home
(home, irrigation, municipal, industrial)

- WELL COMPLETION DATA:
- (1) diameter (inches) 4"
 - (2) total depth (feet) 230
 - (3) static water level (feet) 160 below top of ground.
 - (4) casing PVC (material) 230 (depth)
 - (size) If telescope see back.
 - (5) screen 9' (length) 229 (depth to top)
 - 4" gravel type (size) (material)
 - (6) pump 1/2 (HP) 10 (yield gpm)
 - 220V (type power)
 - (7) electric log No (yes or no)

(organization running log)
(8) how well bottom plugged Cap

DRILLERS REMARKS:

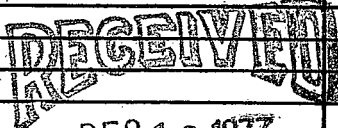


DEC 19 1977

MISS. BD. OF WATER COMM

If well telescopes please sketch and show depths.

GROUND LEVEL

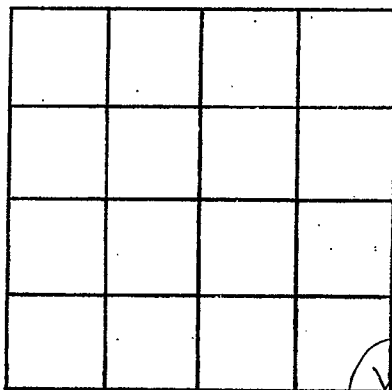

SECTION 1

Please indicate well location X.

ADDITIONAL INFORMATION

If more than one screen, show locations of each on sketch.