

MARSHALL

S 2005

6/22/78

MISSISSIPPI BOARD OF WATER COMMISSIONERS  
416 North State Street  
Jackson, Mississippi 39201

WATER WELL DRILLERS LOG

6-22-78 date well completed  
Peanut West Superwell Co. firm name  
Marshall county well located


LANDOWNER:	description of formations encountered	from	to
LARRY MARTIN	Clay	0	20
HOLLY SPRINGS, MISS. (mailing address)	Sand	20	240
<b>WELL LOCATION:</b>			
sec. <u>7</u> T. <u>5</u> N. R. <u>3</u> E. <u>15</u> miles <u>South</u> of <u>Holly Springs</u> (distance) (direction) (nearest town)			
<b>WELL PURPOSE:</b> <u>Residential</u> (home, irrigation, municipal, industrial)			
<b>WELL COMPLETION DATA:</b>			
(1) diameter (inches) <u>4</u>			
(2) total depth (feet) <u>240 feet</u>			
(3) static water level (feet) <u>180</u> below above top of ground.			
(4) casing <u>PVC</u> <u>240 feet</u> (material) (depth)			
(size) If telescope see back.			
(5) screen <u>7 ft.</u> <u>233 feet</u> (length) (depth to top)			
(size) <u>4"</u> <u>gravel wood</u> (material)			
(6) pump <u>3/4</u> <u>14</u> (HP) (yield gpm)			
(type power)			
(7) electric log <u>glut.</u> (yes or no)			
(organization running log)			
(8) how well bottom plugged <u>4" cap.</u>			
DRILLERS REMARKS:			

RECEIVED  
JUL 11 1978

MISS. BD. OF WATER COMMISSIONERS

If well telescopes please sketch and show depths.

GROUND LEVEL

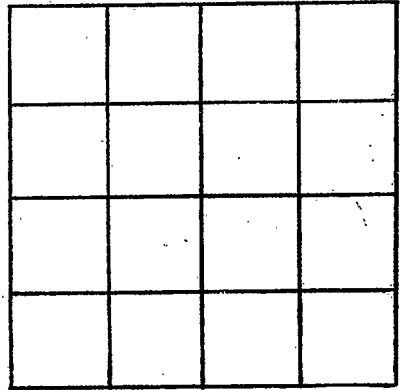

SECTION \_\_\_\_\_

Please indicate well location X.

ADDITIONAL INFORMATION

If more than one screen,  
show locations of each on sketch.