

MARSHALL
S 2006
6/21/78

MISSISSIPPI
BOARD OF WATER COMMISSIONERS
416 North State Street
Jackson, Mississippi 39201

WATER WELL DRILLERS LOG

6-21-78 date well completed Hicks Well Co firm name Marshall county well located


LANDOWNER: <u>Jerry Hines</u>	description of formations encountered	from	to
<u>8861 Brookfield Place</u>	<u>Red Clay</u>	<u>0</u>	<u>15</u>
<u>Southaven, Mo.</u>	<u>White Clay</u>	<u>15</u>	<u>45</u>
(mailing address)	<u>Red Sand</u>	<u>45</u>	<u>130</u>
WELL LOCATION:	<u>white Sand</u>	<u>130</u>	<u>218</u>
sec. <u>32</u> T <u>5</u> N R <u>3</u> E			
<u>3 1/2</u> miles <u>NS</u> of <u>Dabona</u>			
(distance) (direction) (nearest town)			
WELL PURPOSE: <u>Home</u> (home, irrigation, municipal, industrial)			
WELL COMPLETION DATA:			
(1) diameter (inches) <u>4</u>			
(2) total depth (feet) <u>218</u>			
(3) static water level (feet) <u>120</u> below top of ground.			
(4) casing <u>PVC</u> , <u>218</u> (material) (depth)			
_____ if telescope see back. (size)			
(5) screen <u>7</u> , <u>211</u> (length) (depth to top)			
<u>4</u> , <u>gravel type</u> (size) (material)			
(6) pump <u>1/2</u> , <u>10</u> (HP) (yield gpm)			
<u>220V</u> (type power)			
(7) electric log <u>No</u> (yes or no)			
_____ (organization running log)			
(8) how well bottom plugged <u>Cap</u>			
DRILLERS REMARKS:			

RECEIVED
JUN 29 1978

MISS. BD. OF WATER COMM.

If well telescopes please sketch and show depths.

GROUND LEVEL

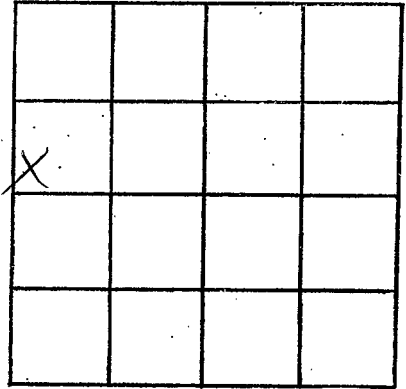

SECTION 32

Please indicate well location X.

ADDITIONAL INFORMATION

If more than one screen,
show locations of each on sketch.