

MARSHALL
S 2007
9-16-78

MISSISSIPPI
 BOARD OF WATER COMMISSIONERS
 416 North State Street
 Jackson, Mississippi 39201
WATER WELL DRILLERS LOG

8 16-78 19 ~~78~~ ~~THE~~ Nicks well Marshall
 date well completed firm name county well located

LANDOWNER: ELISER FRANKLIN	description of formations encountered	from	to
RT-5	Red CLAY	0	15
HOLLY SPRINGS, MISS (mailing address)	Red SAND & CLAY	15	160
	White SAND	160	205

WELL LOCATION:
 sec. 5 T 45 N R 3 E ?
 2 miles N of Colona
 (distance) (direction) (nearest town)

WELL PURPOSE: HOME
 (home, irrigation, municipal, industrial)

- WELL COMPLETION DATA:
- (1) diameter (inches) 4"
 - (2) total depth (feet) 205
 - (3) static water level (feet) 135 below top of ground.
 - (4) casing PVC, 205
 (material) (depth)
 if telescope see back.
 (size) 7"
 - (5) screen 7'
 (length) (depth to top)
 4" Inside Gravel
 (size) (material)
 - (6) pump 3/4 10
 (HP) (yield gpm)
 220 Elec
 (type power)
 - (7) electric log _____
 (yes or no)

 (organization running log)
 - (8) how well bottom plugged C/P


DRILLERS REMARKS:

RECEIVED
 SEP 25 1978

MISS. BD. OF WATER COMMISSIONERS

If well telescopes please sketch and show depths.

GROUND LEVEL

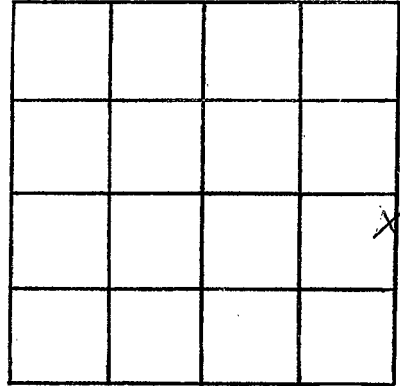

SECTION _____

Please indicate well location X.

ADDITIONAL INFORMATION

If more than one screen, show locations of each on sketch.