

Marshall
S 2008
11-1-78

MISSISSIPPI
 BOARD OF WATER COMMISSIONERS
 416 North State Street
 Jackson, Mississippi 39201

WATER WELL DRILLERS LOG

11-1 1978 Olbrison & Ford Marshall
 date well completed firm name county well located

LANDOWNER: James Peel

description of formations encountered	from	to
<u>Clay</u>	<u>0</u>	<u>18</u>
<u>sand</u>	<u>18</u>	<u>60</u>
<u>Clay</u>	<u>60</u>	<u>140</u>
<u>sand</u>	<u>140</u>	<u>185</u>
<u>Clay</u>	<u>185</u>	<u>200</u>
<u>sand</u>	<u>200</u>	<u>260</u>

Nalley Spring Miss
 (mailing address)

WELL LOCATION:

sec. 4 T. 5 N. R. 3 E.
3 miles N of Law Hill
 (distance) (direction) (nearest town)

WELL PURPOSE: farm
 (home, irrigation, municipal, industrial)

WELL COMPLETION DATA:

- (1) diameter (inches) 4"
- (2) total depth (feet) 260
- (3) static water level (feet) 190 below above top of ground:
- (4) casing PVC 250
 (material) (depth)
 (size) If telescope see back.
- (5) screen 10' 250
 (length) (depth to top)
4" PVC
 (size) (material)
- (6) pump 3/4 10
 (HP) (yield gpm)
elc.
 (type power)
- (7) electric log (yes or no) _____
 (organization running log) _____
- (8) how well bottom plugged Cap

DRILLERS REMARKS:


Miss. Board of Water Comm.

APR 4 1979

RECEIVED

If well telescopes please sketch and show depths.

GROUND LEVEL

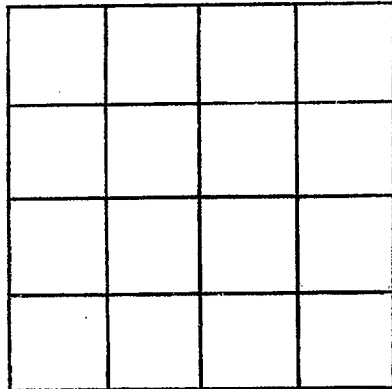

SECTION _____

Please indicate well location X.

ADDITIONAL INFORMATION

If more than one screen, show locations of each on sketch.