

MARSHALL
S 2009
5-17-79

MISSISSIPPI
BOARD OF WATER COMMISSIONERS
416 North State Street
Jackson, Mississippi 39201

WATER WELL DRILLERS LOG

5-17-79 date well completed 79 Hicks Well Co. firm name Marshall county well located

LANDOWNER:
Mattie Ingram
Rt. 5, Holly Springs
(mailing address)

description of formations encountered	from	to
Red Clay	0	25
Red sand	25	70
Red sand & white	70	140
White sand	140	208

WELL LOCATION:
sec. 7 T 5 N R 3 E
miles of Gahna
(distance) (direction) (nearest town)

WELL PURPOSE: home
(home, irrigation, municipal, industrial)

WELL COMPLETION DATA:

(1) diameter (inches) 4 in

(2) total depth (feet) 208

(3) static water level (feet) 170 below top of ground.

(4) casing Plastic 208 (material) (depth)

(size) if telescope see back.

(5) screen 47 ft 201 (length) (depth to top)
4 in gravel (size) (material)

(6) pump 1/2 10 (HP) (yield gpm)
220 (type power)

(7) electric log No (yes or no)

(organization running log)

(8) how well bottom plugged Cap

DRILLERS REMARKS:


Miss. Board of Water Comm.

JUN - 1 1979

RECEIVED

If well telescopes please sketch and show depths.

GROUND LEVEL

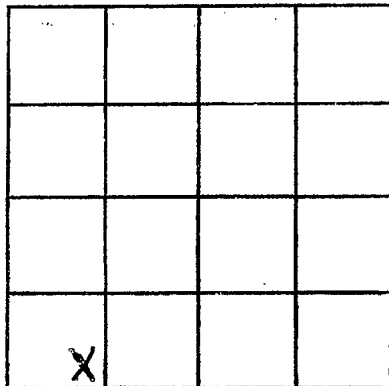

SECTION 1

Please indicate well location X.

ADDITIONAL INFORMATION

If more than one screen, show locations of each on sketch.