

MARSHALL

S 2011

7-11-79

MISSISSIPPI
BOARD OF WATER COMMISSIONERS
416 North State Street
Jackson, Mississippi 39201

WATER WELL DRILLERS LOG

7-11

date well completed

1979

Dean Kent Bumpfel
firm name

Marshall
county well located

LANDOWNER:		description of formations encountered	from	to
Troy Kibburn Waterford, Miss. (mailing address)				
WELL LOCATION:		sand	10	50
sec. 23 T 5 N R 3 E 5 miles S.W. of Waterford (distance) (direction) (nearest town)		clay	50	55
WELL PURPOSE: <u>Municipal</u> (home, irrigation, municipal, industrial)		sand	55	210
WELL COMPLETION DATA:				
(1) diameter (inches)	4"			
(2) total depth (feet)	210 feet			
(3) static water level (feet)	125			
	below top of ground.			
(4) casing	PVC 210 feet			
	(material) (depth)			
	(size) if telescope see back.			
(5) screen	24' 203 feet			
	(length) (depth to top)			
	4" gravel well			
	(size) (material)			
(6) pump	3/4 14			
	(HP) (yield gpm)			
	(type power)			
(7) electric log	Elect.			
	(yes or no)			
	(organization running log)			
(8) how well bottom plugged	4' soft			
DRILLERS REMARKS:				


Miss. Board of Water Comm.

AUG 6 1979

RECEIVED

If well telescopes please sketch and show depths.

GROUND LEVEL

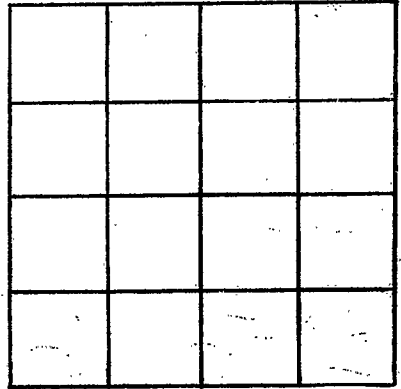

SECTION _____

Please indicate well location X.

ADDITIONAL INFORMATION

If more than one screen,
show locations of each on sketch.