

Marshall
S

2012

10-23-79

10-23-

MISSISSIPPI
BOARD OF WATER COMMISSIONERS
416 North State Street
Jackson, Mississippi 39201

WATER WELL DRILLERS LOG

79 Hicks Well Co.

Marshall
county well located

LANDOWNER:

Corrin Jamison
Pt. 5, 2nd Springs
(mailing address)

description of formations encountered

from

to

clay 0 30
Red sand 30 120
white sand 120 230

WELL LOCATION:

sec. 7 T. 5 N R. 3 E
Galena
miles of (distance) (direction) (nearest town)

WELL PURPOSE: name
(home, irrigation, municipal, industrial)

WELL COMPLETION DATA:

- (1) diameter (inches) 4 in
- (2) total depth (feet) 230
- (3) static water level (feet) _____ below/above top of ground.
- (4) casing Plastic, 230, (material) (depth)
- (size) if telescope see back.
- (5) screen 7 ft, 223 (length) (depth to top)
4 in, Gravel (size) (material)
- (6) pump 1/2 HP, 10 (HP) (yield gpm)
220 (type power)
- (7) electric log No (yes or no)
- (organization running log)
- (8) how well bottom plugged Cap


DRILLERS REMARKS:

DEPT. OF NATURAL RESOURCES
BUREAU OF LAND & WATER RESOURCES

NOV 13 1979
RECEIVED

If well telescopes please sketch and show depths.

GROUND LEVEL

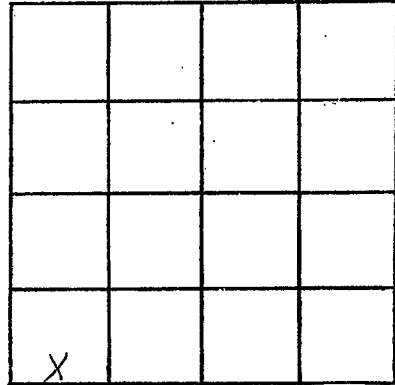

SECTION 7

Please indicate well location X.

ADDITIONAL INFORMATION

If more than one screen,
show locations of each on sketch.