

Marshall  
S 2013  
4-1-80  
4-1

MISSISSIPPI  
BOARD OF WATER COMMISSIONERS  
416 North State Street  
Jackson, Mississippi 39201

WATER WELL DRILLERS LOG

date well completed 1980 firm name Penitent Pump Well county well located Marshall

LANDOWNER:	description of formations encountered	from	to
Kim Show Waterford, Miss. <small>(mailing address)</small>			
<b>WELL LOCATION:</b> sec. 23 T 5 N R 3 E 6 miles S.W. of Waterford <small>(distance) (direction) (nearest town)</small>			
<b>WELL PURPOSE:</b> <i>Drinking</i> <small>(home, irrigation, municipal, industrial)</small>			
<b>WELL COMPLETION DATA:</b>			
(1) diameter (inches) 4"			
(2) total depth (feet) 210 feet			
(3) static water level (feet) 130 below above top of ground.			
(4) casing PVC 210 feet <small>(material) (depth)</small> <small>(size) If telescope see back.</small>			
(5) screen 14" 203 feet <small>(length) (depth to top)</small> 4" gravel well <small>(size) (material)</small>			
(6) pump 3/4 14 <small>(HP) (yield gpm)</small>			
<small>(type power)</small>			
(7) electric log <i>elect</i> <small>(yes or no)</small> <small>(organization running log)</small>			
(8) how well bottom plugged 4" cof.			
<b>DRILLERS REMARKS:</b>			


DEPT. OF NATURAL RESOURCES  
BUREAU OF LAND & WATER RESOURCES

APR 22 1980

RECEIVED

If well telescopes please sketch and show depths.

GROUND LEVEL

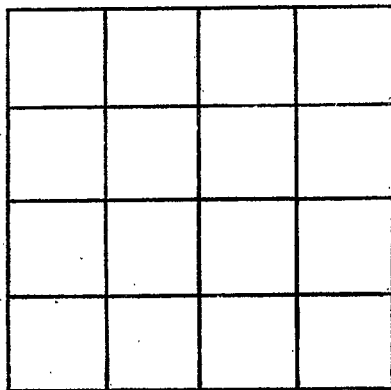

SECTION \_\_\_\_\_

Please indicate well location X.

ADDITIONAL INFORMATION

If more than one screen,  
show locations of each on sketch.