

MARSHALL

S 2014

6-17-80

June 13 1980

date well completed

MISSISSIPPI
BOARD OF WATER COMMISSIONERS
416 North State Street
Jackson, Mississippi 39201

WATER WELL DRILLERS LOG

De Witt Enterprises, Inc. Marshall
firm name county well located

LANDOWNER:	description of formations encountered	from	to
George Kelley			
At 2, Waterford, Miss. (mailing address)	Sand	20	75
WELL LOCATION:	Clay	75	85
sec 26 T 5 N R 3 E	Sand	85	160
4 miles South of Waterford (distance) (direction) (nearest town)			
WELL PURPOSE: <u>Drinking</u> (home, irrigation, municipal, industrial)			
WELL COMPLETION DATA:			
(1) diameter (inches) <u>4"</u>			
(2) total depth (feet) <u>160 feet</u>			
(3) static water level (feet) <u>60</u> below above top of ground.			
(4) casing <u>PVC, 160 feet</u> (material) (depth)			
(size) If telescope see back.			
(5) screen <u>7 ft., 153 feet</u> (length) (depth to top)			
<u>4"</u> <u>gravel</u> (size) (material)			
(6) pump <u>3/4</u> <u>17</u> (HP) (yield gpm)			
(type power)			
(7) electric log <u>Elect.</u> (yes or no)			
(organization running log)			
(8) how well bottom plugged <u>4" CB</u>			
DRILLERS REMARKS:			


DEPT. OF NATURAL RESOURCES
BUREAU OF LAND & WATER RESOURCES

JUL 16 1980

RECEIVED

If well telescopes please sketch and show depths.

GROUND LEVEL

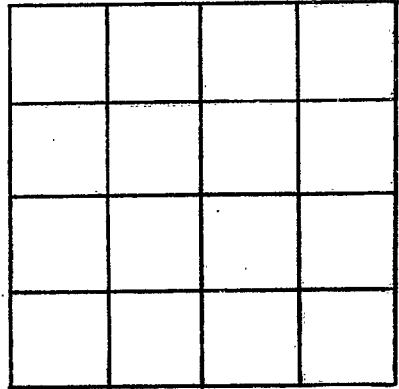

SECTION _____

Please indicate well location X.

ADDITIONAL INFORMATION

If more than one screen, show locations of each on sketch.