

MARSHALL

S 2015

7-24-80

MISSISSIPPI  
 BOARD OF WATER COMMISSIONERS  
 416 North State Street  
 Jackson, Mississippi 39201

WATER WELL DRILLERS LOG

7-24-80 date well completed      Hicks Well Co firm name      Marshall county well located

LANDOWNER: <u>A. J. Brown</u>	description of formations encountered	from	to
<u>Plot 3</u>			
<u>Holly Springs</u> (mailing address)	<u>clay</u>	<u>0</u>	<u>30</u>
WELL LOCATION: sec. <u>7</u> T <u>5</u> N R <u>3</u> E _____ miles _____ of <u>La Bona</u> (distance) (direction) (nearest town)	<u>Red sand</u>	<u>30</u>	<u>190</u>
WELL PURPOSE: <u>Home</u> (home, irrigation, municipal, industrial)	<u>White sand</u>	<u>190</u>	<u>230</u>
WELL COMPLETION DATA: (1) diameter (inches) <u>4</u>			
(2) total depth (feet) <u>230</u>			
(3) static water level (feet) <u>180</u> below above top of ground.			
(4) casing <u>PVC</u> <u>230</u> (material) (depth)			
_____ If telescope see back. (size)			
(5) screen <u>7'</u> <u>223</u> (length) (depth to top)			
<u>4"</u> <u>gravel</u> Type (size) (material)			
(6) pump <u>1/2</u> <u>10</u> (HP) (yield gpm)			
<u>2200</u> (type power)			
(7) electric log <u>No</u> (yes or no)			
_____ (organization running log)			
(8) how well bottom plugged <u>Cap</u>			

DRILLERS REMARKS:


DEPT. OF NATURAL RESOURCES  
 BUREAU OF LAND & WATER RESOURCES

SEP 26 1980

RECEIVED

If well telescopes please sketch and show depths.

GROUND LEVEL

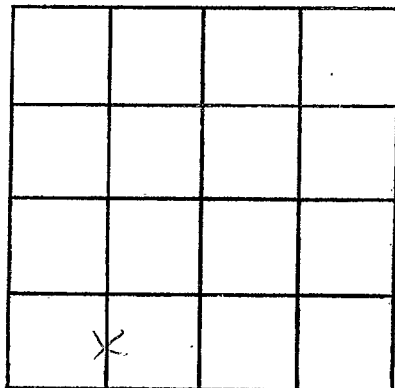

SECTION 7

Please indicate well location X.

ADDITIONAL INFORMATION

If more than one screen,  
show locations of each on sketch.