

Marshall
S 2017
7-20-80

MISSISSIPPI
BOARD OF WATER COMMISSIONERS
416 North State Street
Jackson, Mississippi 39201

WATER WELL DRILLERS LOG

July 20 1980 R. L. Carpenter Marshall
date well completed firm name county well located

LANDOWNER: Morrise Malone
Louis Hill, Miss

RFD
(mailing address)

WELL LOCATION:

sec 31 T 5 N R 3 E
1 1/2 miles NE of Louis Hill
(distance) (direction) (nearest town)

WELL PURPOSE: Home
(home, irrigation, municipal, industrial)

WELL COMPLETION DATA:

- (1) diameter (inches) 4
- (2) total depth (feet) 210
- (3) static water level (feet) 125 below above top of ground.
- (4) casing Plaster, 200'
(material) (depth)
(size) If telescope see back.
- (5) screen 10', 200'
(length) (depth to top)
4", Plastic
(size) (material)
- (6) pump 3/4, 12
(HP) (yield gpm)
Elec.
(type power)
- (7) electric log no
(yes or no)
(organization running log)

(8) how well bottom plugged PVC cap

description of formations encountered

from to


Surface Soil	0	20
Med. Red Sand	20	55
Med white sand	55	90
White Coarse Sand	90	165
White Clay	165	175
White Coarse Sand	175	210

DRILLERS REMARKS:

DEPT. OF NATURAL RESOURCES
BUREAU OF LAND & WATER RESOURCES
APR 24 1981
RECEIVED

If well telescopes please sketch and show depths.

GROUND LEVEL

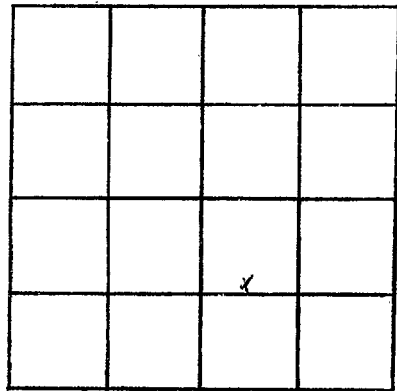

SECTION 31

Please indicate well location X.

ADDITIONAL INFORMATION

A series of horizontal lines for writing additional information, starting below the 'ADDITIONAL INFORMATION' header and extending down to the bottom of the page.

If more than one screen, show locations of each on sketch.