

Marshall
S 2018
8-3-80

MISSISSIPPI
BOARD OF WATER COMMISSIONERS
416 North State Street
Jackson, Mississippi 39201

WATER WELL DRILLERS LOG

8-3 1980 Hicks Well Co. Marshall
date well completed firm name county well located

LANDOWNER: <u>Joe Martin</u>	description of formations encountered		from	to
<u>B.O.D.</u>				
<u>Waterford, Mo.</u> (mailing address)	<u>C. Day</u>		<u>0</u>	<u>30</u>
	<u>Sand</u>		<u>30</u>	<u>160</u>
WELL LOCATION: sec. <u>31</u> T. <u>S</u> N. R. <u>3</u> E <u>3</u> miles <u>NE</u> of <u>Lanskill</u> (distance) (direction) (nearest town)	<u>White Sand</u>		<u>160</u>	<u>200</u>
WELL PURPOSE: <u>Home</u> (home, irrigation, municipal, industrial)				
WELL COMPLETION DATA:				
(1) diameter (inches) <u>4"</u>				
(2) total depth (feet) <u>200</u>				
(3) static water level (feet) <u>170</u> below top of ground.				
(4) casing <u>PVC</u> , <u>200</u> , (material) (depth) <u>4"</u> if telescope see back. (size)				
(5) screen <u>71</u> , <u>193</u> (length) (depth to top) <u>4"</u> , <u>gravel type</u> (size) (material)				
(6) pump <u>1/2</u> , <u>10</u> (HP) (yield gpm) <u>220 V</u> (type power)				
(7) electric log <u>No.</u> (yes or no)				
(organization running log)				
(8) how well bottom plugged <u>Cap</u>				
DRILLERS REMARKS:				


DEPT. OF NATURAL RESOURCES
BUREAU OF LAND & WATER RESOURCES

SEP 26 1980

RECEIVED

If well telescopes please sketch and show depths.

GROUND LEVEL

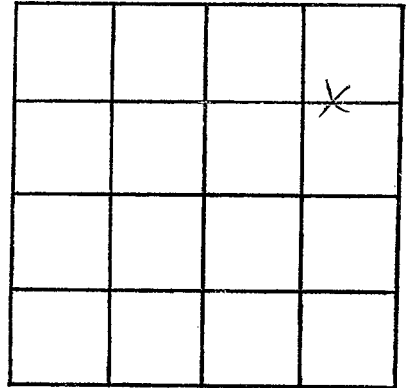

SECTION 31

Please indicate well location X.

ADDITIONAL INFORMATION

If more than one screen, show locations of each on sketch.