

**MISSISSIPPI DEPARTMENT OF NATURAL RESOURCES**  
**Bureau of Land and Water Resources**  
 Southport Mall  
 P.O. Box 10631  
 Jackson, Mississippi 39209  
**WATER WELL DRILLERS LOG**

Marshall  
S 2019  
11-3-80

11-3 1980 Penitentiary Camp well Marshall  
 date well completed firm name county well located

LANDOWNER:	description of formations encountered	from	to
<u>Jack Vincent</u> <u>Waterford, Miss.</u> (mailing address)			
WELL LOCATION:	<u>Sand</u>	<u>20</u>	<u>170</u>
sec. <u>26</u> T. <u>5</u> N. R. <u>3</u> E.			
<u>4</u> miles <u>South</u> of <u>Waterford</u> (distance) (direction) (nearest town)			
WELL PURPOSE: <u>Driller</u> (home, irrigation, municipal, industrial)			
WELL COMPLETION DATA:			
(1) diameter (inches) <u>4"</u>			
(2) total depth (feet) <u>170 feet</u>			
(3) static water level (feet) <u>130</u> below above top of ground.			
(4) casing <u>PVC</u> , <u>170 feet</u> (material) (depth)			
<u>      </u> (size) if telescope see back.			
(5) screen <u>7 ft.</u> , <u>163 feet</u> (length) (depth to top)			
<u>4"</u> , <u>iron wall</u> (size) (material)			
(6) pump <u>3/4</u> , <u>14</u> (HP) (yield gpm)			
<u>      </u> (type power)			
(7) electric log <u>Elect.</u> (yes or no)			
<u>      </u> (organization running log)			
(8) how well bottom plugged <u>4" cap.</u>			
DRILLERS REMARKS:			


DEPT. OF NATURAL RESOURCES  
 BUREAU OF LAND & WATER RESOURCES

NOV 12 1980

**RECEIVED**

If well telescopes please  
sketch and show depths.

GROUND LEVEL

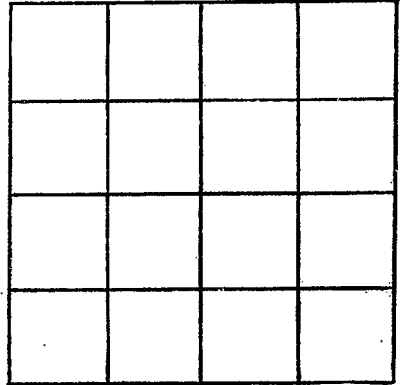

SECTION \_\_\_\_\_

Please indicate well location X.

ADDITIONAL INFORMATION

If more than one screen,  
show locations of each on sketch.