

MISSISSIPPI DEPARTMENT OF NATURAL RESOURCES

Bureau of Land and Water Resources

Southport Mall

P.O. Box 10631

Jackson, Mississippi 39209 <sup>12</sup>

WATER WELL DRILLERS LOG

MARSHALL
S 2020
12-12-80

12-12 1980 date well completed      Hick Well Co. firm name      Marshall county well located


LANDOWNER: <u>O.B. Peeler</u>	description of formations encountered	from	to
<u>Rt. 2</u>			
<u>Waterford, Mo.</u> (mailing address)	<u>White Sand</u>	<u>110</u>	<u>170</u>
WELL LOCATION: sec. <u>22</u> T <u>5</u> N R <u>3</u> E <u>4</u> miles <u>S</u> of <u>Waterford</u> (distance) (direction) (nearest town)			
WELL PURPOSE: <u>Home</u> (home, irrigation, municipal, industrial)			
WELL COMPLETION DATA: (1) diameter (inches) <u>4</u> (2) total depth (feet) <u>170</u> (3) static water level (feet) <u>100</u> below top of ground. (4) casing <u>PVC</u> , <u>170</u> (material) (depth) (size) if telescope see back. (5) screen <u>12 in.</u> , <u>158</u> (length) (depth to top) <u>02-013</u> , <u>permeable type</u> (size) (material) (6) pump <u>1/2</u> , <u>10</u> (HP) (yield-gpm) <u>220V</u> (type power) (7) electric log <u>No</u> (yes or no) (organization running log) (8) how well bottom plugged <u>Cap</u>			
DRILLERS REMARKS:			

DEPT. OF NATURAL RESOURCES  
BUREAU OF LAND & WATER RESOURCES

RECEIVED  
DEC 23 1980

If well telescopes please sketch and show depths.

GROUND LEVEL

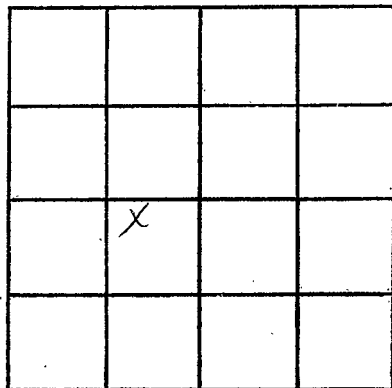

SECTION 22

Please indicate well location X.

ADDITIONAL INFORMATION

If more than one screen,  
show locations of each on sketch.