

MISSISSIPPI DEPARTMENT OF NATURAL RESOURCES

Bureau of Land and Water Resources

Southport Mall

P.O. Box 10631

Jackson, Mississippi 39209

WATER WELL DRILLERS LOG

Marshall
S 2021
12-22-80

12-22 1980 Hick Well Co. Marshall
date well completed firm name county well located

LANDOWNER: R. Allen Ester Turner

description of formations encountered from to

Pt. 5 Helena
Holly Springs, Ms.
(mailing address)

Red Clay 0 15
Clay & Sand 15 175
White Sand 175 233

WELL LOCATION:

sec. 7 T. 5 N. R. 3 E.
(S) (W)
miles of Helena
(distance) (direction) (nearest town)

WELL PURPOSE: stomach
(home, irrigation, municipal, industrial)

WELL COMPLETION DATA:

- (1) diameter (inches) 4
- (2) total depth (feet) 233
- (3) static water level (feet) 180 below top of ground.
- (4) casing PVC 233
(material) (depth)
- if telescope see back.
(size)
- (5) screen 12 221
(length) (depth to top)
- 02 gravel type
(size) (material) (SF)
- (6) pump 3/4 10
(HP) (yield gpm)
- 220V
(type power)
- (7) electric log No
(yes or no)

(organization running log)

(8) how well bottom plugged Cap

DRILLERS REMARKS:


DEPT. OF NATURAL RESOURCES
BUREAU OF LAND & WATER RESOURCES

JAN 12 1981

RECEIVED

If well telescopes please sketch and show depths.

GROUND LEVEL

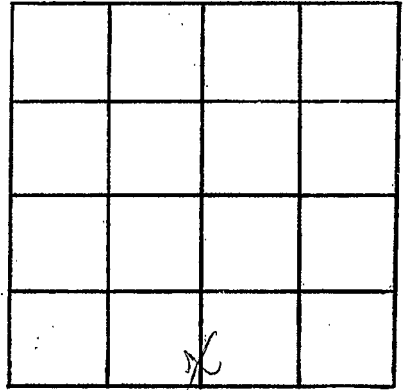

SECTION 7

Please indicate well location X.

ADDITIONAL INFORMATION

If more than one screen, show locations of each on sketch.