

MARSHALL
S 2023
2/23/81
Feb. 23

MISSISSIPPI
 BOARD OF WATER COMMISSIONERS
 416 North State Street
 Jackson, Mississippi 39201

WATER WELL DRILLERS LOG

date well completed

firm name

county well located

19 81 R L Carpenter Marshall

LANDOWNER:

Lake Johnson
Waterford, Miss

description of formations encountered

from

to

<u>Surface Soil</u>	<u>0</u>	<u>20</u>
<u>red white soil</u>	<u>20</u>	<u>65</u>
<u>white clay</u>	<u>65</u>	<u>76</u>
<u>white fine sand</u>	<u>76</u>	<u>92</u>
<u>white coarse sand</u>	<u>92</u>	<u>110</u>

(mailing address)

WELL LOCATION:

sec. 12 T 5 N R. 3 E
S W
1 1/2 miles north of Waterford
 (distance) (direction) (nearest town)

WELL PURPOSE:

(home, irrigation, municipal, industrial)


Home

WELL COMPLETION DATA:

- (1) diameter (inches) 4
- (2) total depth (feet) 110
- (3) static water level (feet) 63 below top of ground.
- (4) casing PVC 100'
 (material) (depth)
 (size) if telescope see back.
- (5) screen 10' 100'
 (length) (depth to top)
1/2" PVC
 (size) (material)
- (6) pump 1/2 10
 (HP) (yield gpm)
2 hp
 (type power)
- (7) electric log No.
 (yes or no)

(organization running log)

(8) how well bottom plugged PVC cap

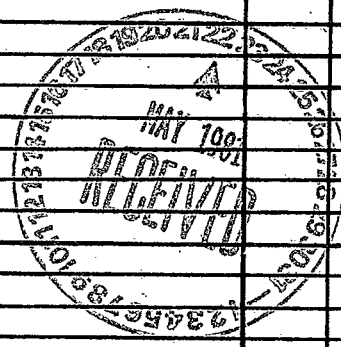

DRILLERS REMARKS:

