

Marshall
S 2024
2/27/81
Feb 27

MISSISSIPPI
 BOARD OF WATER COMMISSIONERS
 416 North State Street
 Jackson, Mississippi 39201

WATER WELL DRILLERS LOG

date well completed 1981 firm name R. L. Carpenter county well located Marshall

LANDOWNER: Clyde Hilmer
Waterford, Miss.

description of formations encountered	from	to
<u>Surface Soil</u>	<u>0</u>	<u>15</u>
<u>med. white sand</u>	<u>15</u>	<u>40</u>
<u>white clay & white fine sand</u>	<u>40</u>	<u>77</u>
<u>med. white sand</u>	<u>77</u>	<u>85</u>
<u>white coarse sand</u>	<u>85</u>	<u>105</u>


(mailing address)

WELL LOCATION:
 sec. 1 T. 5 N. R. 3 E.
1 1/2 miles North of Waterford
 (distance) (direction) (nearest town)

WELL PURPOSE: Private
 (home, irrigation, municipal, industrial)

WELL COMPLETION DATA:

- (1) diameter (inches) 4
- (2) total depth (feet) 105
- (3) static water level (feet) 20 below top of ground
- (4) casing PVC 95'
 (material) (depth)
- _____ if telescope see back.
 (size)
- (5) screen 10' 95'
 (length) (depth to top)
- 4" PVC
 (size) (material)
- (6) pump 1/2 10
 (HP) (yield gpm)
- Electric
 (type power)
- (7) electric log No.
 (yes or no)
- _____ (organization running log)
- (8) how well bottom plugged PVC cap

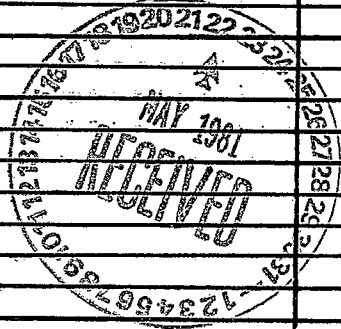

DRILLERS REMARKS:

