

Marshall
S 2025.
4/8/81
H-R

MISSISSIPPI
BOARD OF WATER COMMISSIONERS
416 North State Street
Jackson, Mississippi 39201

WATER WELL DRILLERS LOG

Frost Well Supply Marshall
firm name county well located

date well completed

firm name

county well located

LANDOWNER: Shaw's Grocery
Waterford, Miss.

description of formations encountered	from	to
	clay	0
sand	22	55
Brown clay	55	75
sand	75	115

(mailing address)

WELL LOCATION:

sec. 4-T-3-N R-3-E
412 miles South of Waterford
(distance) (direction) (nearest town)

WELL PURPOSE:

(home, irrigation, municipal, industrial)

WELL COMPLETION DATA:

- diameter (inches) 4"
- total depth (feet) 115
- static water level (feet) 75 below above top of ground.
- casing PVC (material), (depth) 4" (size) if telescope see back.
- screen 5' (length), (depth to top) 6" (size) (material)
- pump 3/4 (HP), (yield gpm) Elec. (type power)
- electric log NO (yes or no)
(organization running log)
- how well bottom plugged *cap.*

DEPT. OF NATURAL RESOURCES
BUREAU OF LAND & WATER RESOURCES


MAY 18 1981

RECEIVED

DRILLERS REMARKS:

If well telescopes please sketch and show depths.

GROUND LEVEL

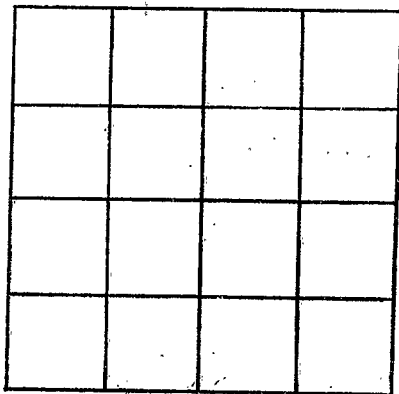

SECTION _____

Please indicate well location X.

ADDITIONAL INFORMATION

If more than one screen,
show locations of each on sketch.