


MISSISSIPPI DEPARTMENT OF NATURAL RESOURCES
 Bureau of Land and Water Resources
 Southport Mall
 P.O. Box 10631

Jackson, Mississippi 39209
WATER WELL DRILLERS LOG

MARSHALL
S 2006

6/10/81 16-70 1981 Hicks Well Co. Marshall
 date well completed firm name county well located


LANDOWNER:	description of formations encountered	from	to
<u>Cora Munday</u> <u>Pt. 5</u>			
<u>Holly Springs, Mo.</u> (mailing address)	<u>Red Sand</u>	<u>10</u>	<u>150</u>
WELL LOCATION: sec. <u>13</u> T. <u>5</u> N. R. <u>3</u> E.	<u>White Clay</u>	<u>150</u>	<u>160</u>
<u>1</u> miles <u>S</u> of <u>Holly Springs</u> (distance) (direction) (nearest town)	<u>White Sand</u>	<u>160</u>	<u>185</u>
WELL PURPOSE: <u>Home</u> (home, irrigation, municipal, industrial)			
WELL COMPLETION DATA:			
(1) diameter (inches) <u>4</u>			
(2) total depth (feet) <u>185</u>			
(3) static water level (feet) <u>125</u> below top of ground.			
(4) casing <u>PVC</u> , <u>185</u> (material) (depth)			
<u>—</u> if telescope see back. (size)			
(5) screen <u>12</u> , <u>173</u> (length) (depth to top)			
<u>4"</u> , <u>PVC</u> (size) (material)			
(6) pump <u>1/2</u> , <u>10</u> (HP) (yield gpm)			
<u>220V</u> (type power)			
(7) electric log <u>No</u> (yes or no)			
(organization running log)			
(8) how well bottom plugged <u>Cap</u>			

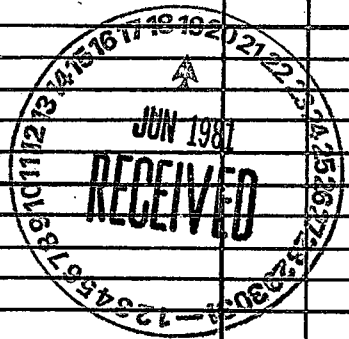

DRILLERS REMARKS:

If well telescopes please sketch and show depths.

GROUND LEVEL

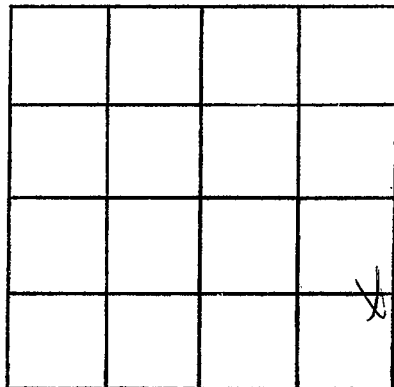

SECTION 13

Please indicate well location X.

ADDITIONAL INFORMATION

If more than one screen,
show locations of each on sketch.