

MISSISSIPPI DEPARTMENT OF NATURAL RESOURCES

Bureau of Land and Water Resources

Southport Mall

P.O. Box 10631


Jackson, Mississippi 39209

WATER WELL DRILLERS LOG

Marshall
S 2027
6-17-81


6-17 19 81 Hicks Well Co. Marshall
 date well completed firm name county well located

LANDOWNER:	description of formations encountered	from	to
<u>Co Luister Curry</u> <u>Rt. 2 Box 150</u> <u>Waterford, Mo.</u> (mailing address)			
WELL LOCATION: sec <u>23</u> T <u>5</u> N R <u>3</u> E <u>3</u> miles <u>NW</u> of <u>Waterford</u> (distance) (direction) (nearest town)	<u>Red Sand</u>	<u>10</u>	<u>50</u>
WELL PURPOSE: <u>Hayne</u> (home, irrigation, municipal, industrial)	<u>White Sand & Clay</u>	<u>50</u>	<u>110</u>
WELL COMPLETION DATA:	<u>White Sand</u>	<u>110</u>	<u>170</u>
(1) diameter (inches) <u>4</u>			
(2) total depth (feet) <u>170</u>			
(3) static water level (feet) <u>120</u> below above top of ground.			
(4) casing <u>PVC</u> , <u>170</u> , (material) (depth) <u>—</u> if telescope see back. (size)			
(5) screen <u>12</u> , <u>170</u> (length) (depth to top) <u>4"</u> <u>gravel type</u> (size) (material)			
(6) pump <u>1/2</u> , <u>10</u> (HP) (yield gpm) <u>220V</u> (type power)			
(7) electric log <u>No</u> (yes or no) (organization running log)			
(8) how well bottom plugged <u>Cap</u>			
DRILLERS REMARKS:			

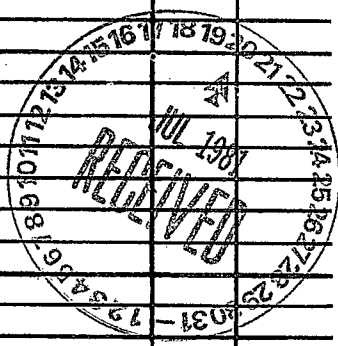

If well telescopes please sketch and show depths.

GROUND LEVEL

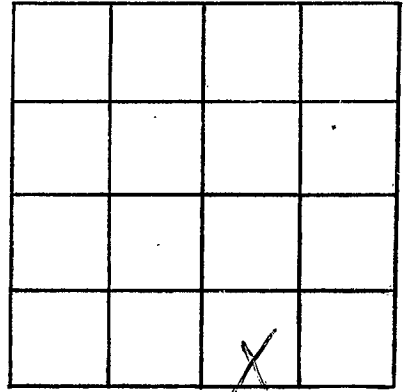

SECTION 23

Please indicate well location X.

ADDITIONAL INFORMATION

If more than one screen,
show locations of each on sketch.