

MISSISSIPPI DEPARTMENT OF NATURAL RESOURCES

Bureau of Land and Water Resources

Southport Mall

P.O. Box 10631

Jackson, Mississippi 39209

WATER WELL DRILLERS LOG

MARSHALL
S 2029
9-17-81

HICKS WELL CO.

Rt. 1 Box 157

Senatobia, MS 38668

Marshall

9-17 1981
 date well completed

county well located

LANDOWNER: <i>Jean Scrugg</i> <i>Rt. 5 Box 205</i>	description of formations encountered	from	to
<i>Haley Springs, Mo.</i> <i>509 (mailing address) 38635</i>	<i>Red Sand</i>	<i>0</i>	<i>20</i>
WELL LOCATION: sec. <i>7</i> T. <i>5</i> N. R. <i>3</i> E. <i>(S) (W)</i> <i>Salena</i> (distance) miles (direction) of (nearest town)	<i>White clay + sand</i>	<i>20</i>	<i>175</i>
WELL PURPOSE: <i>Home</i> (home, irrigation, municipal, industrial)	<i>White Sand</i>	<i>175</i>	<i>245</i>
WELL COMPLETION DATA: (1) diameter (inches) <i>4</i> (2) total depth (feet) <i>245</i> (3) static water level (feet) <i>170</i> below above top of ground. (4) casing <i>PVC, 245</i> (material) (depth) <i>—</i> (size) If telescope see back. (5) screen <i>12, 233</i> (length) (depth to top) <i>4", gravel + PVC</i> (size) (material) (6) pump <i>3/4, 10</i> (HP) (yield gpm) <i>220V</i> (type power) (7) electric log <i>No</i> (yes or no) (organization running log) (8) how well bottom plugged <i>CRP</i>			
DRILLERS REMARKS:			


DEPT. OF NATURAL RESOURCES
 BUREAU OF LAND & WATER RESOURCES

SEP 24 1981

RECEIVED

If well telescopes please sketch and show depths.

GROUND LEVEL

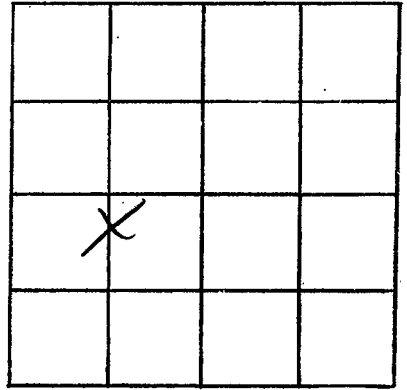

SECTION 7

Please indicate well location X.

ADDITIONAL INFORMATION

If more than one screen,
show locations of each on sketch.